


T. 1 N. R. 28 E. W. M.

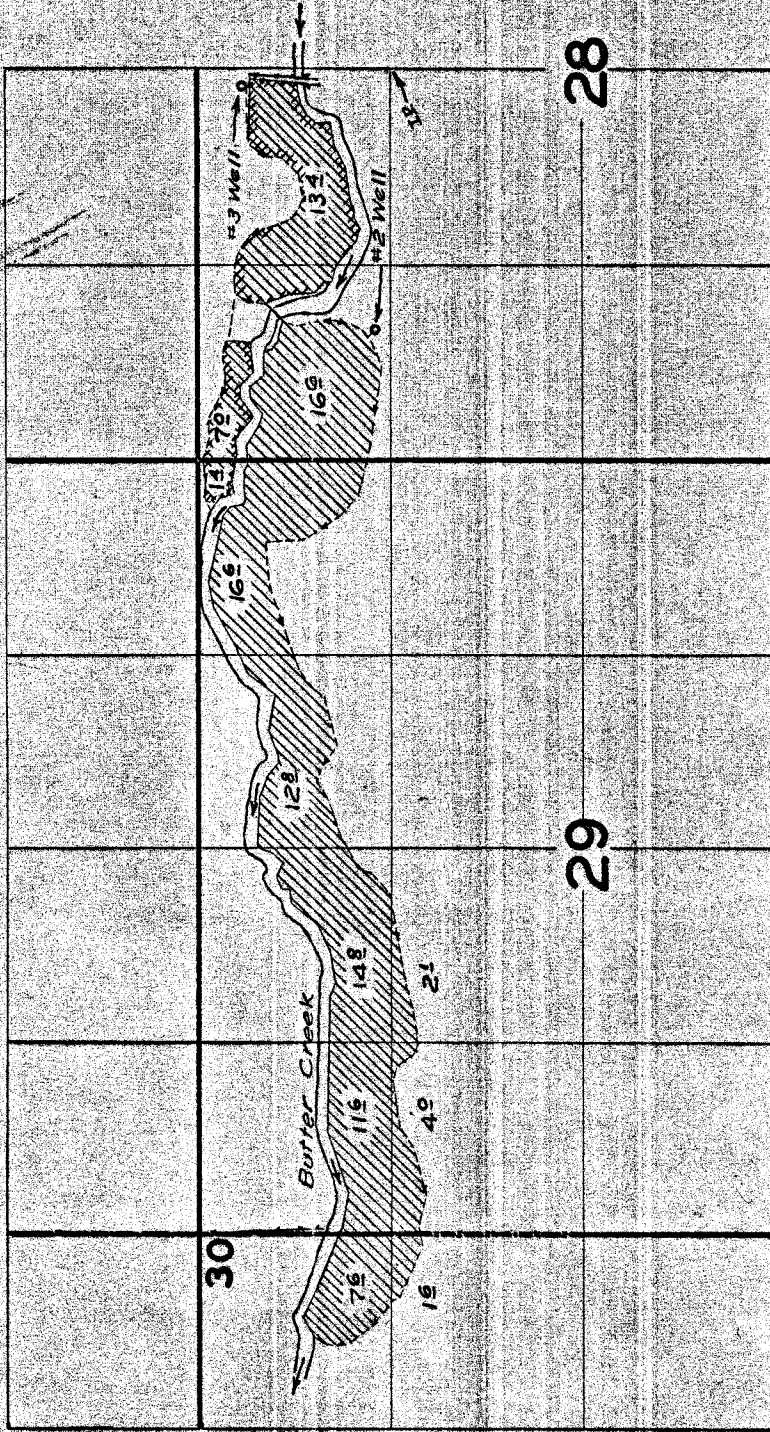

FINAL PROOF SURVEY

UNDER

Application No. G-858 Permit No. G-823

IN NAME OF

ANTONE J. VEY

Surveyed 22 Nov 1958, by W. G. Bishop

G-823
26092