


T. 4S. R. 4W. W.M.

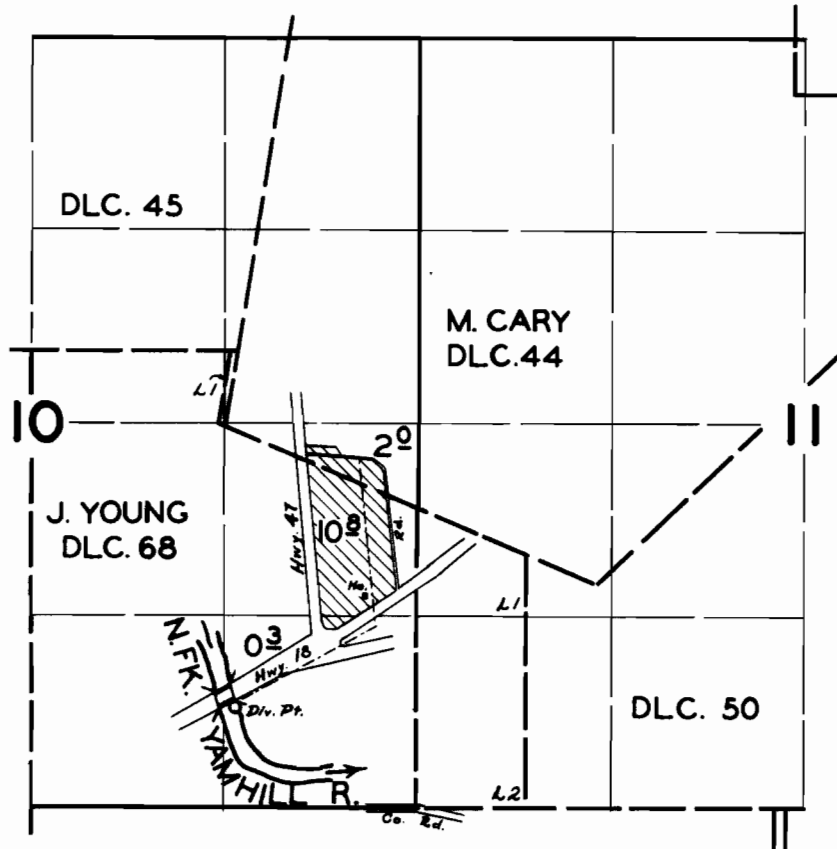

**FINAL PROOF SURVEY**  
UNDER

Application No. 9360 Permit No. 6224  
IN NAME OF

**EVERGREEN MEMORIAL PARK ASSN.**

Surveyed APR. 30 1958, by M. BISH