


T. 24S R. 6E. W.M.

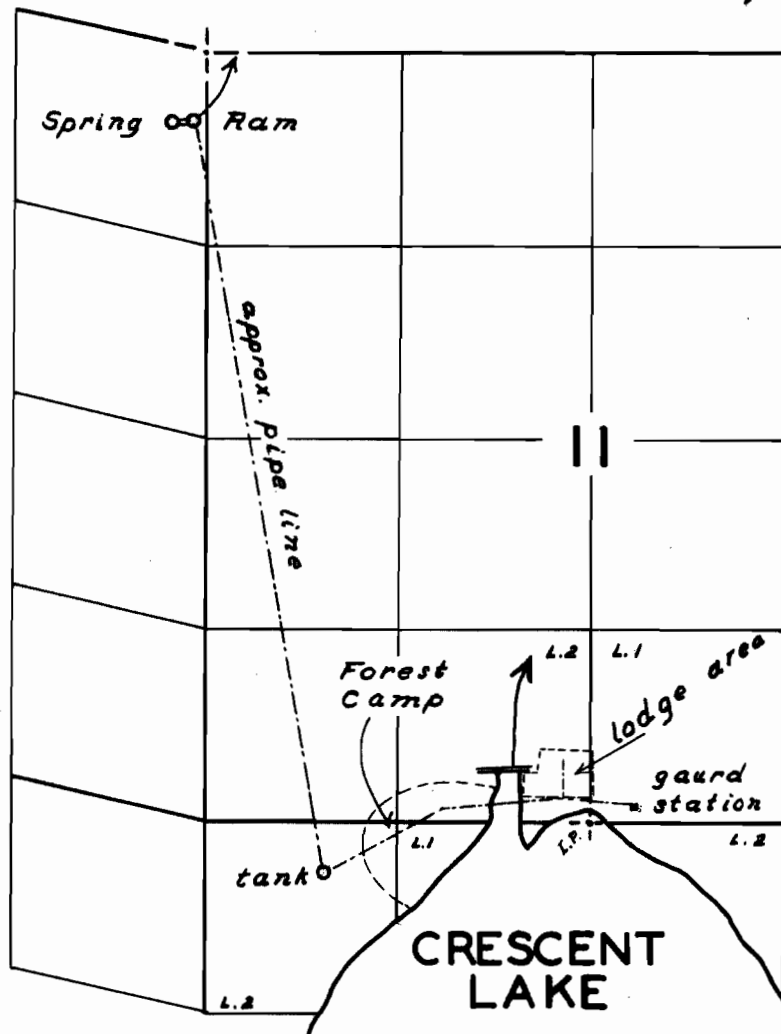

FINAL PROOF SURVEY
UNDER

Application No. 17147 Permit No. 12911
IN NAME OF

United States Forest Service

Surveyed Oct. 16 1958, by W. N. Perry