


T. 2N. R. 10W. W.M.

PACIFIC OCEAN

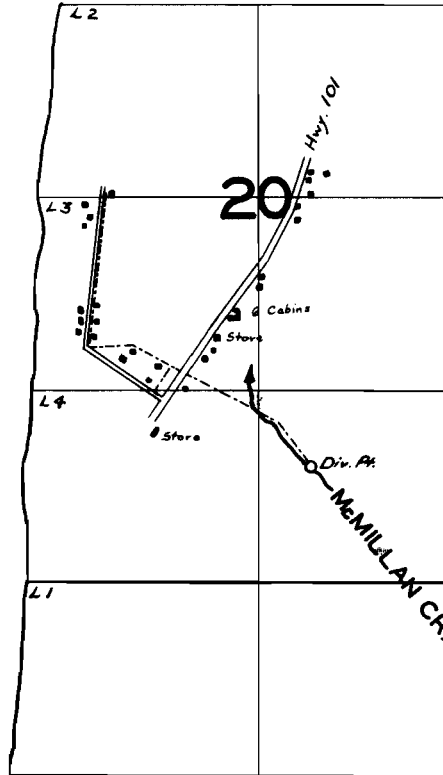

FINAL PROOF SURVEY

UNDER

Application No. 21838... Permit No. 17176.....

IN NAME OF

CITY OF ROCKAWAY

Surveyed AUG. 29, 1957, by C.O. BARTELS