


T. 23S. R. 32E. W.M.

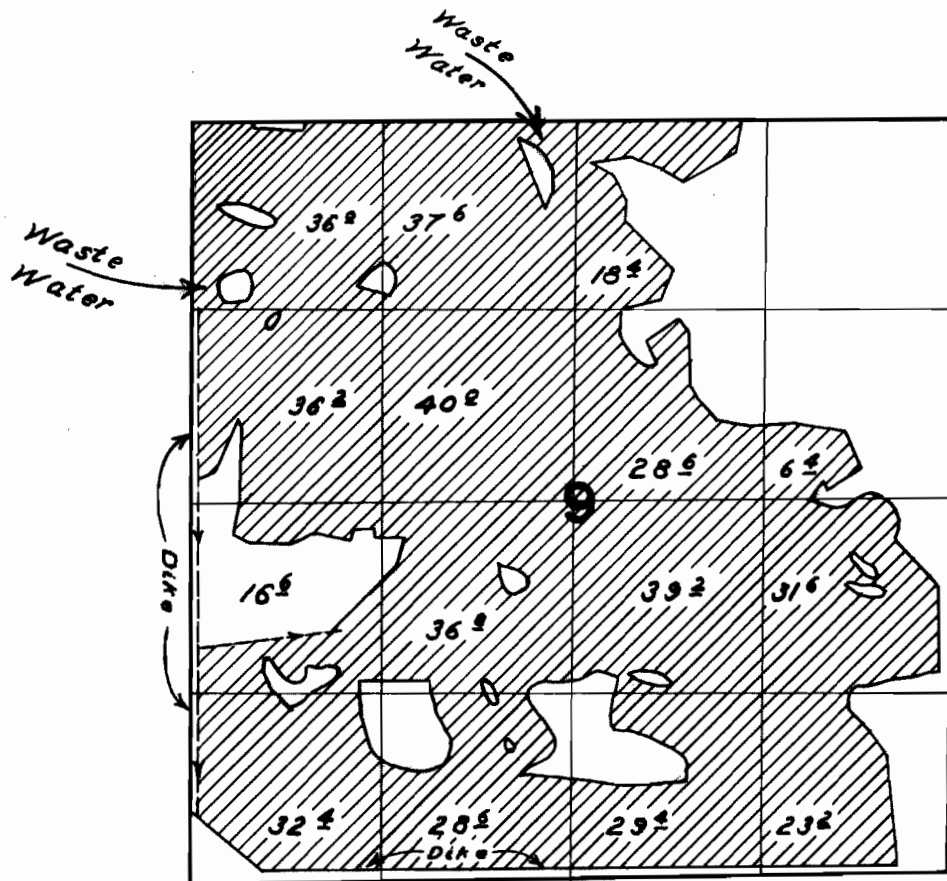

FINAL PROOF SURVEY
UNDER

Application No. 22115 Permit No. 17422
IN NAME OF

J. C. & Lotta J. Clemens

Surveyed July 23 1958, by W. N. Perry