T. 14 S. R. 5 W. W. M.

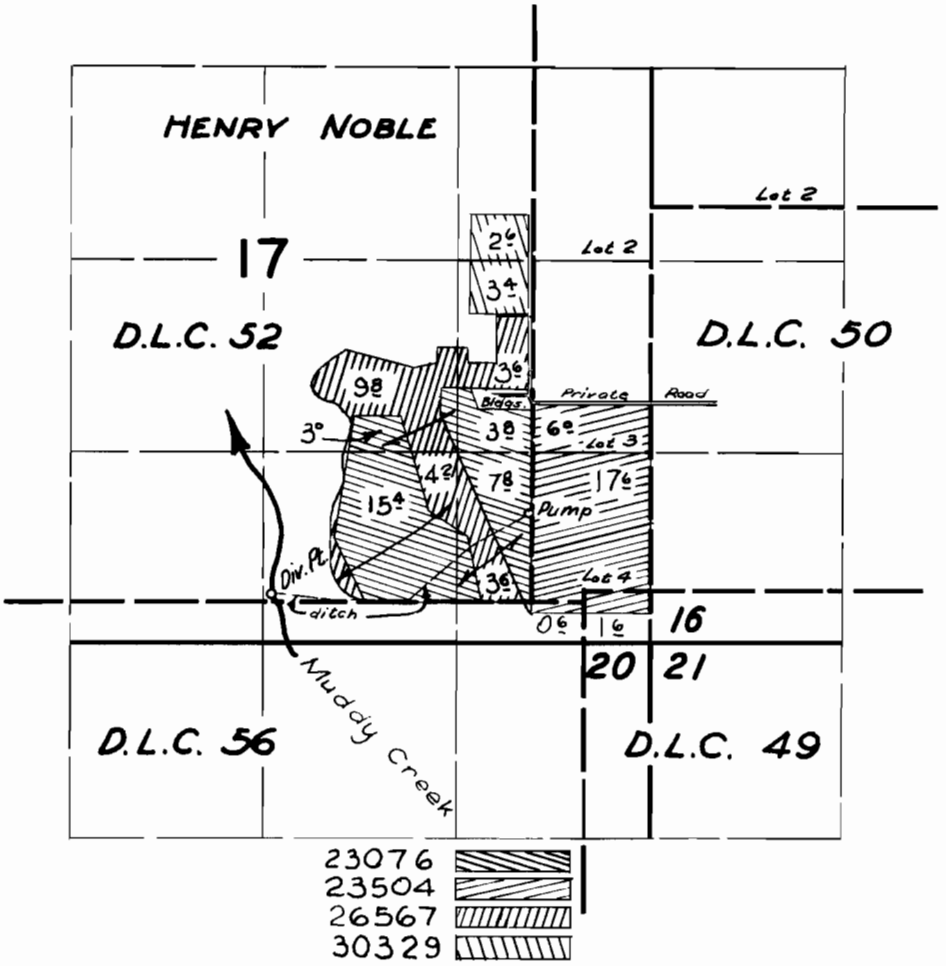

FINAL PROOF SURVEY

UNDER

23076 18209
23504 18578
26567 20815

Application No. 30329 Permit No. 24107

IN NAME OF

CLYDE E. STARR

Surveyed 29 May 1958, by C. O. Bartels

DFJ-40-120