


T. 18 S. R. 8 E. W.M.

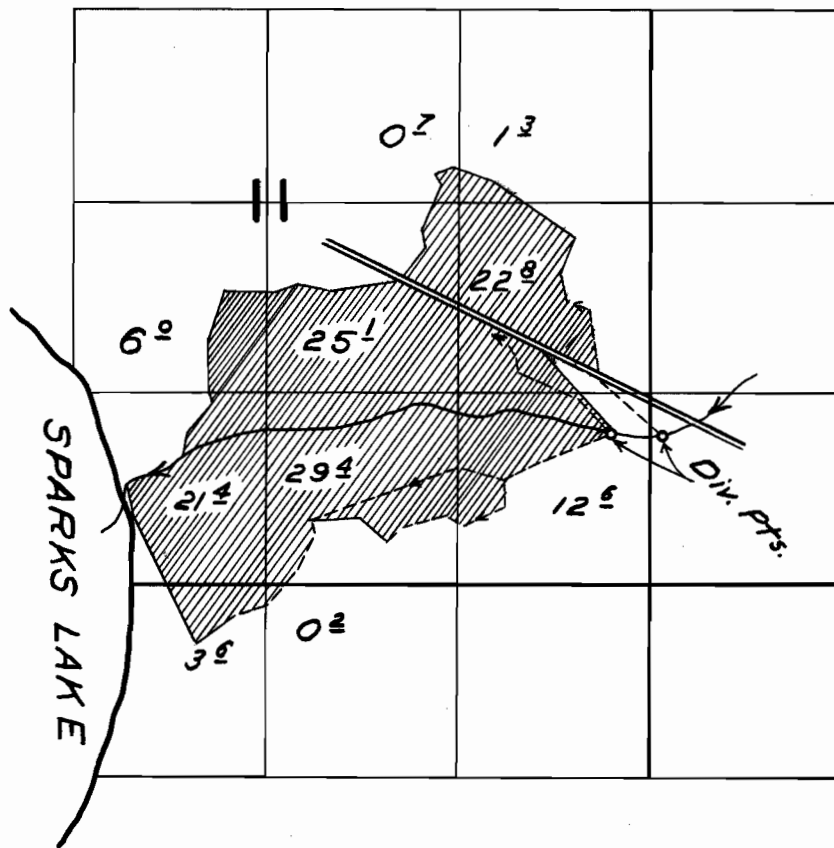

FINAL PROOF SURVEY
UNDER

Application No. 23523 Permit No. 18581 ...
IN NAME OF

U. S. Forest Service

Surveyed Oct. 14 1958, by W. N. Perry