


T 8 S R 6 W W M

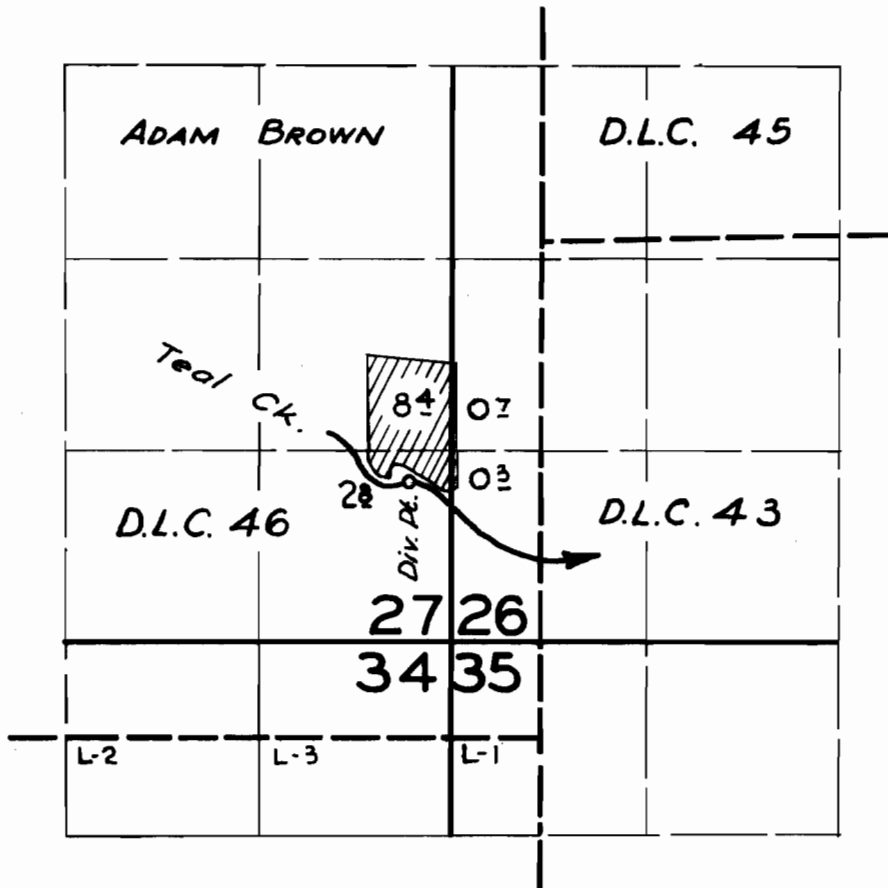

FINAL PROOF SURVEY
UNDER

Application No. 23916... Permit No. 18899...
IN NAME OF

MASON S. SHUTT

Surveyed April 25 1958, by R.H. Whitby.