


T. 7 S. R. 1 W. W. M.

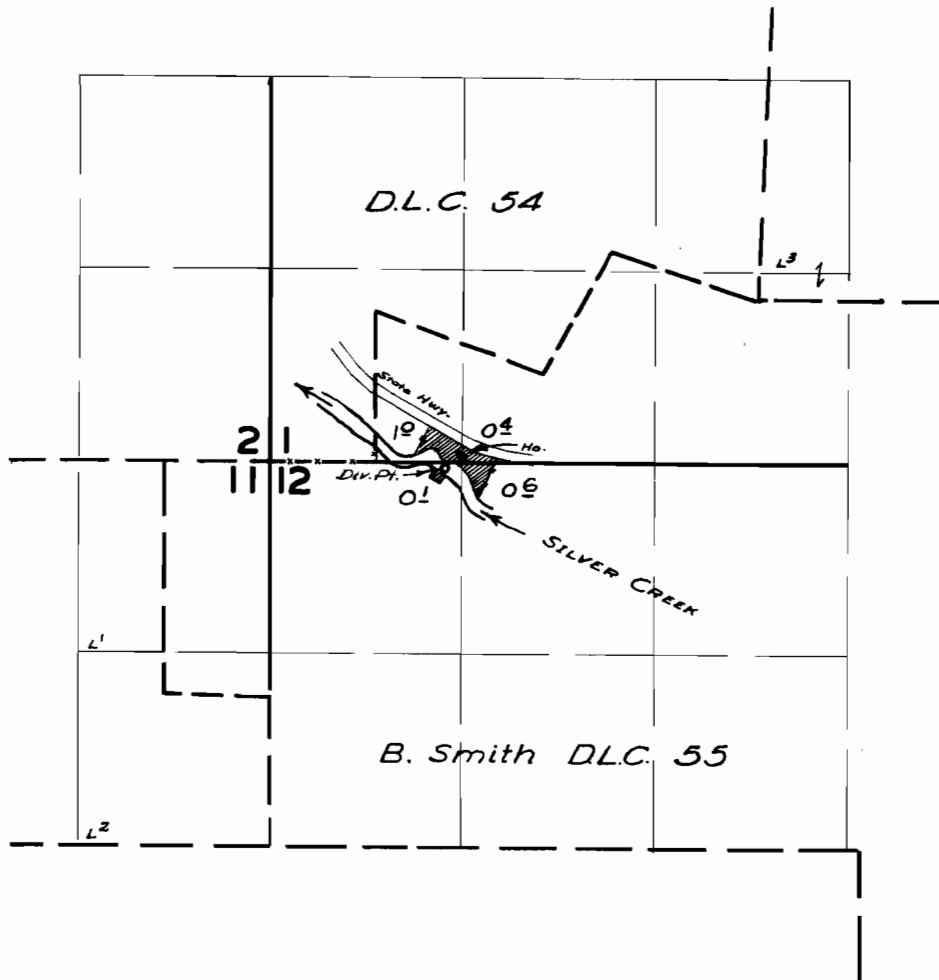

**FINAL PROOF SURVEY**  
UNDER

Application No. 24366 Permit No. 19641  
IN NAME OF

EBER A. OR RUTH D. TETER

Surveyed 23 July 1958, by M. Bish