


T.28S. R.13W. W.M.

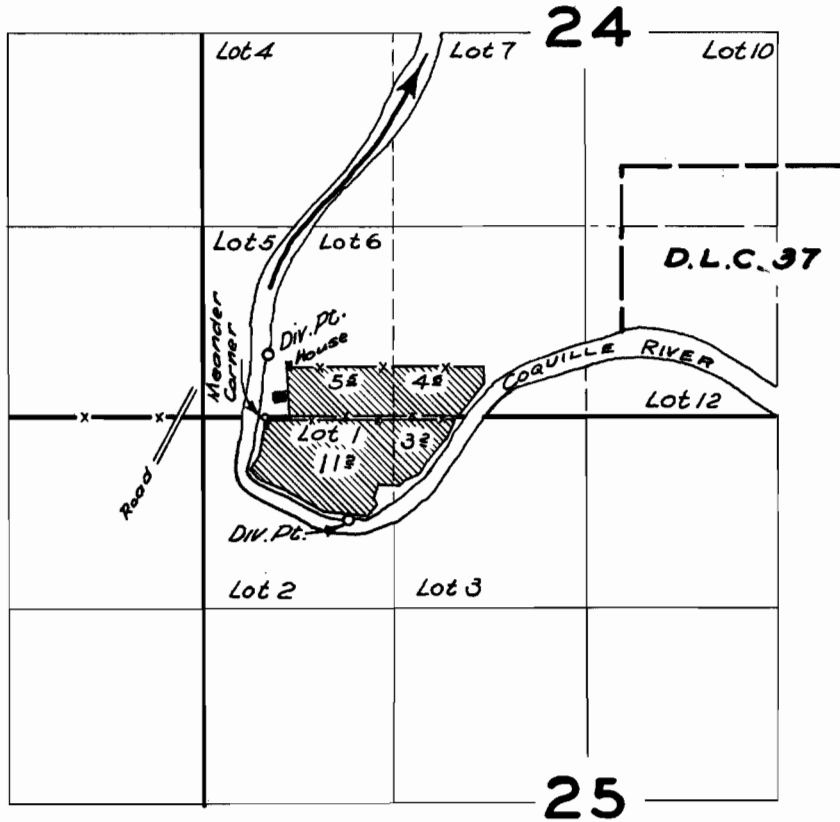

**FINAL PROOF SURVEY**  
UNDER

Application No. 25308 Permit No. 19862  
IN NAME OF

**ERNEST C. BURCHER**

Surveyed 29 May 1959, by M. Bish.

*M.B.*