


T. 39 S., R. 2 W., W.M.

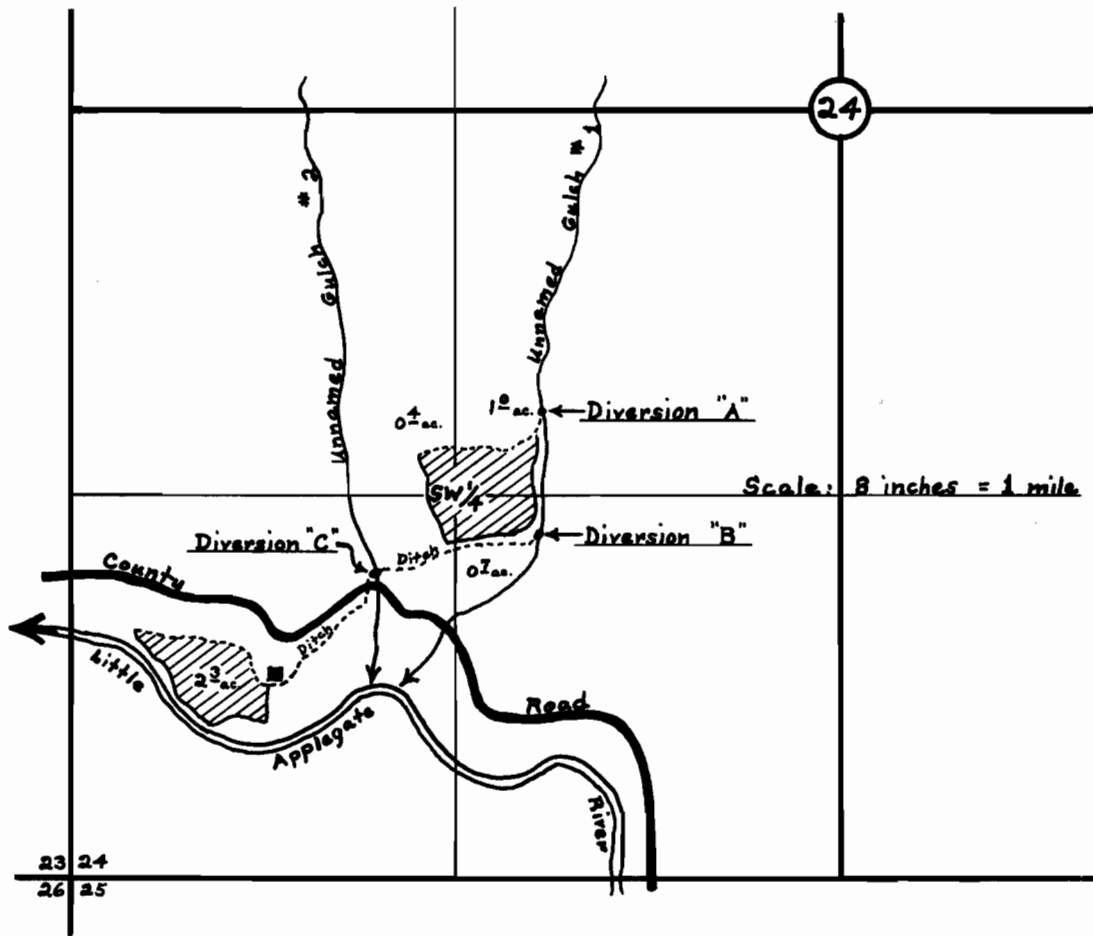

FINAL PROOF SURVEY

UNDER

Application No. 25481 Permit No. 20028

IN NAME OF

W. B. Keele

Surveyed March 17, 1959, by D.C. Hendrix, W.M.