


T. 23S. R. 6E. W.M.

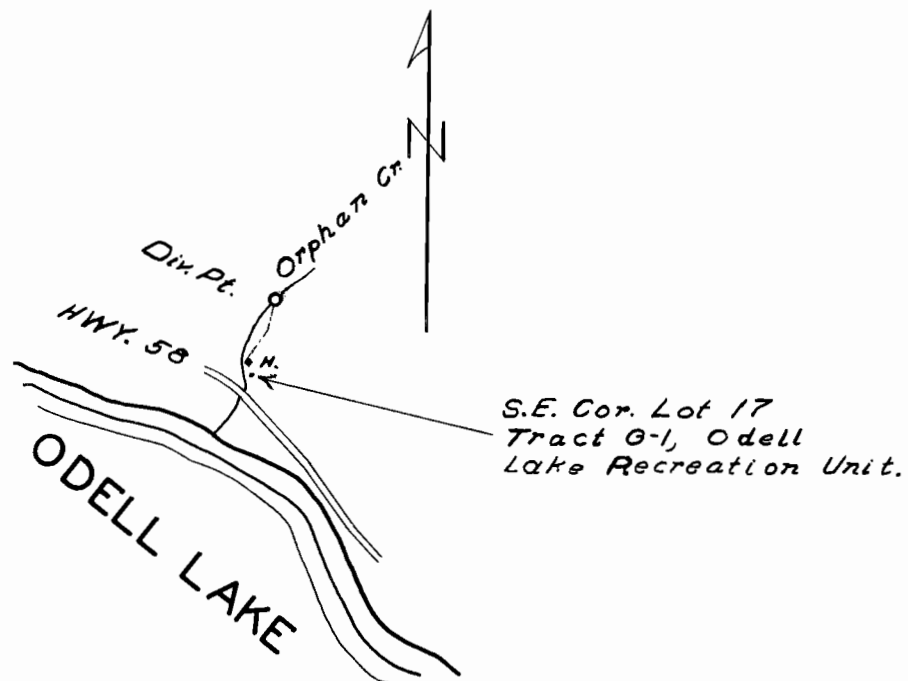

FINAL PROOF SURVEY
UNDER

Application No. 25893 Permit No. 20319
IN NAME OF

C. M. Olson

Surveyed Oct. 16, 1958, by W. N. Perry