


T.I.S.R.19&20 E.W.M.

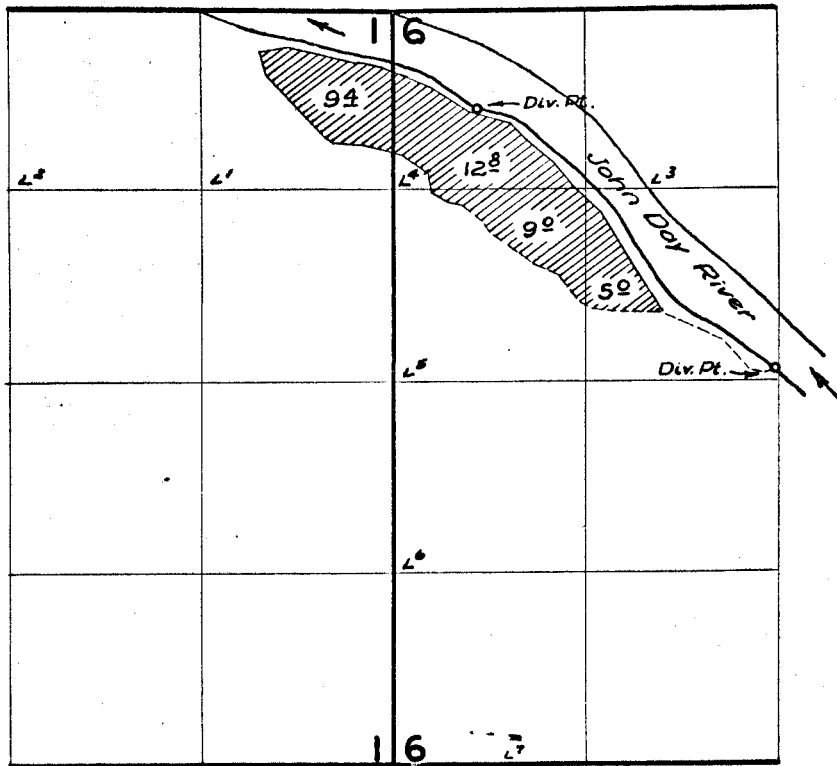

FINAL PROOF SURVEY

UNDER

Application No. 25952 Permit No. 20347
IN NAME OF

ROBERT A. BOYNTON

Surveyed 29 Oct. 1958, by W. Bish