


T.13S. R.1 W.W.M.

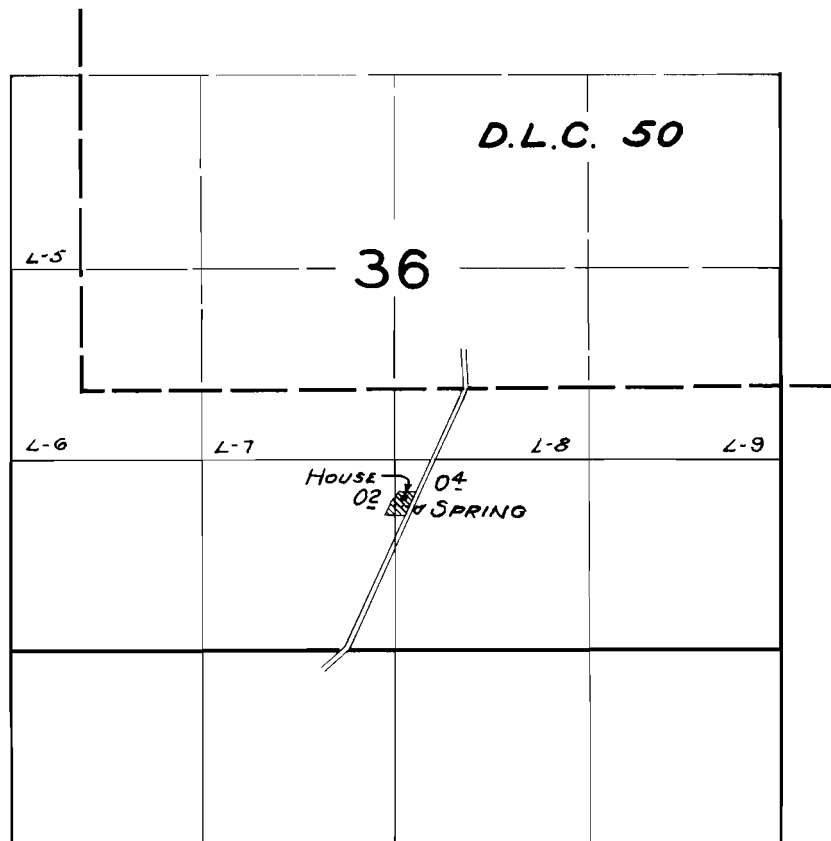

FINAL PROOF SURVEY
UNDER

Application No. 26234. Permit No. 20447.
IN NAME OF

Donald D & Jessie M. Cheek

Surveyed 4 Sept. 1958, by C.O. Bartels ..