


T. 3S. R. 5W. W.M.

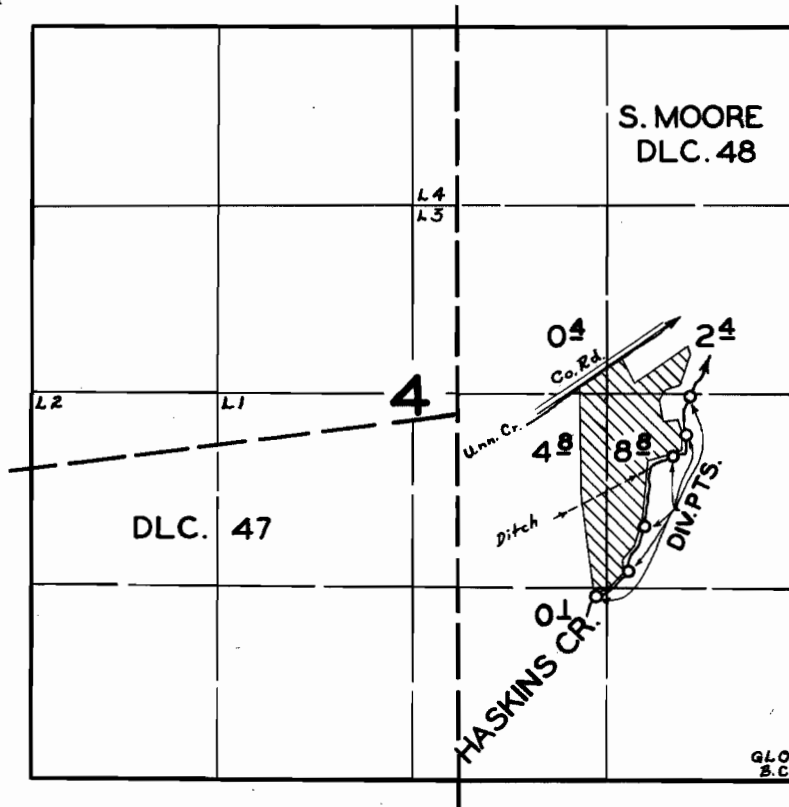

FINAL PROOF SURVEY
UNDER

Application No. 26344 Permit No. 20669
IN NAME OF

HADLEY CHODRICK

Surveyed MAY 6 1958, by M. BISH