


T.3S. R.3W.W.M.

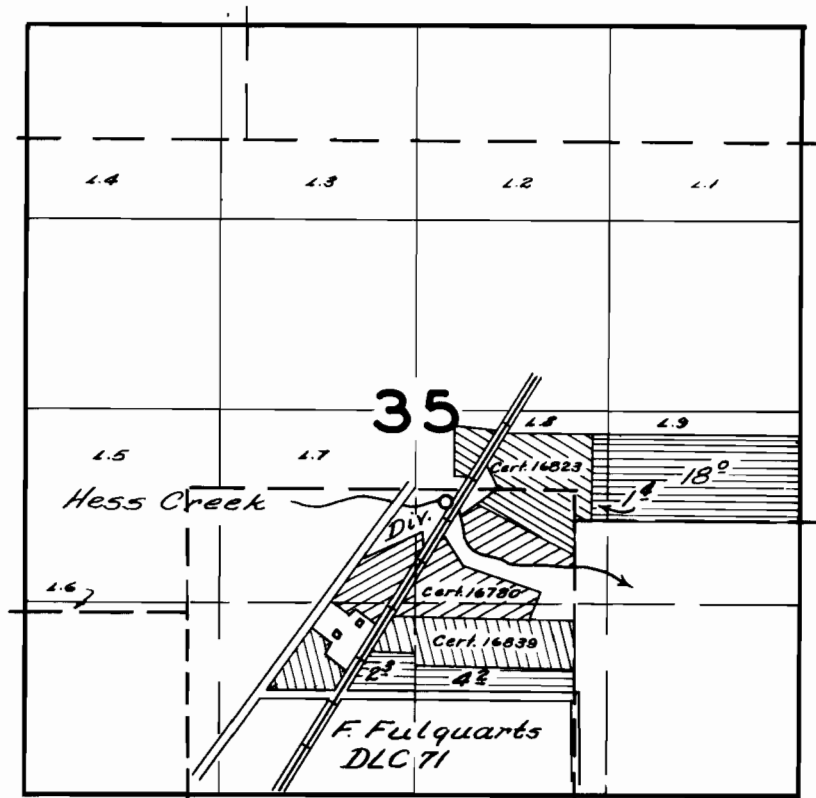

FINAL PROOF SURVEY UNDER

Application No. 26412 Permit No. 20717
IN NAME OF

FRANCIS A. BUCKLEY

Surveyed May 15 1958, by M. Bisk