


T. 5S. R. 6W. W.M.

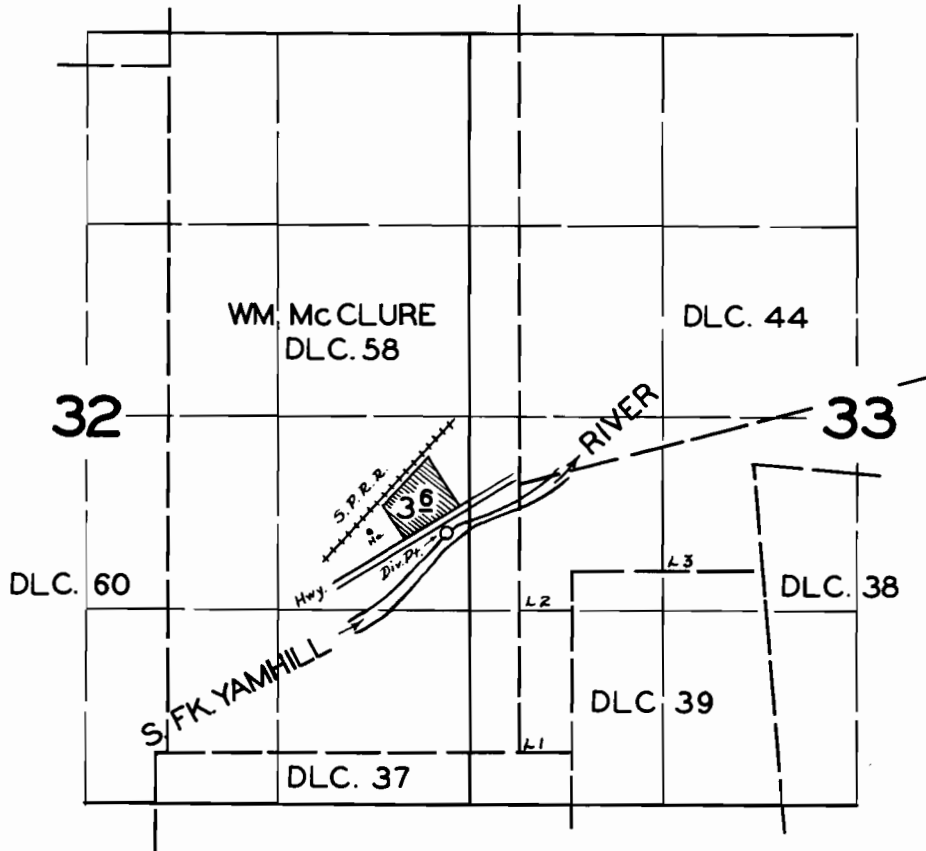

FINAL PROOF SURVEY
UNDER

Application No. 27164 Permit No. 21362
IN NAME OF

Carroll F. Pittman

Surveyed APR. 11 1958, by M. BISH