


T. 9 S. R. 2 W. W. M.

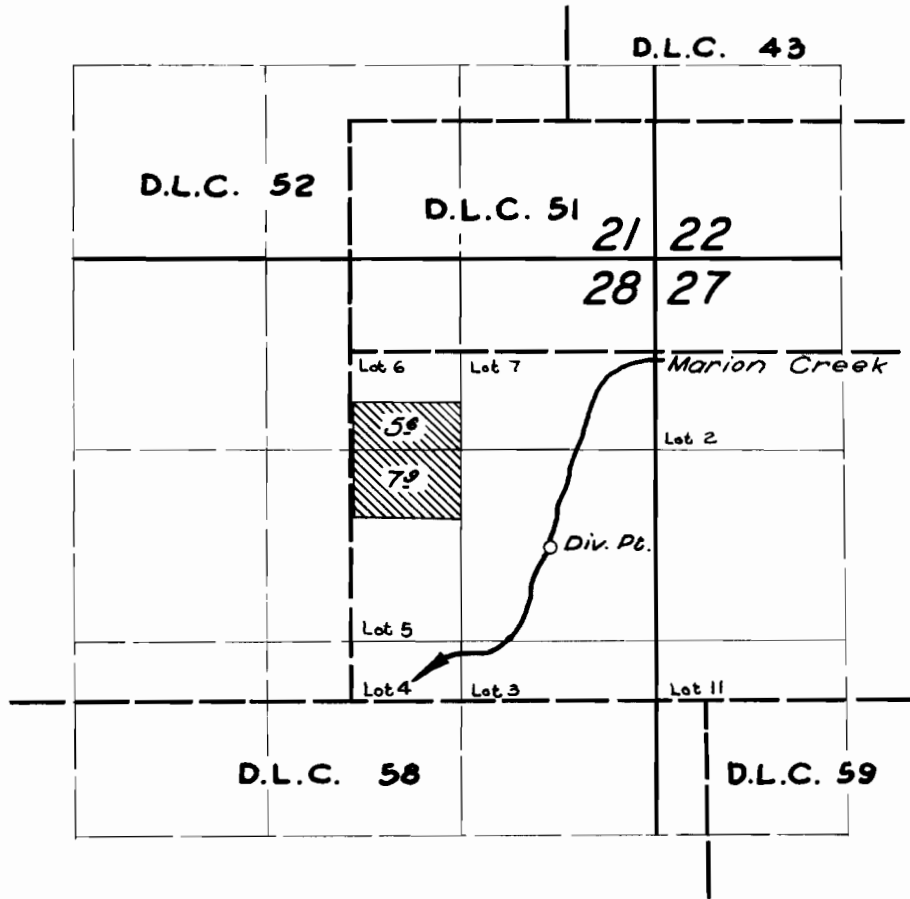

FINAL PROOF SURVEY
UNDER

Application No. 27166 Permit No. 21364
IN NAME OF

WM. A. KIRSCH

Surveyed 28 July 1958, by M. Bish

[Handwritten signature]