


T. 3 S. R. 4 - 5 W. W. M.

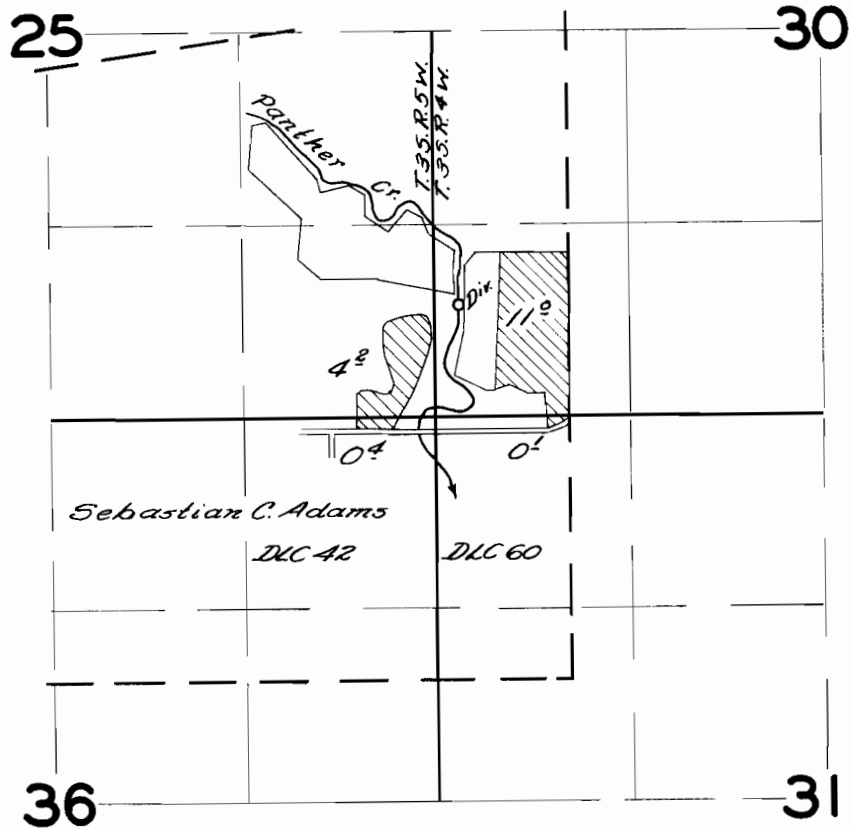

FINAL PROOF SURVEY UNDER

Application No. 27338 Permit No. 21490
IN NAME OF

Karl S. Clinkinbeard Jr.

Surveyed *May 9 1958* by *M. Bish*