


T. 5S. R. 1W. W.M.

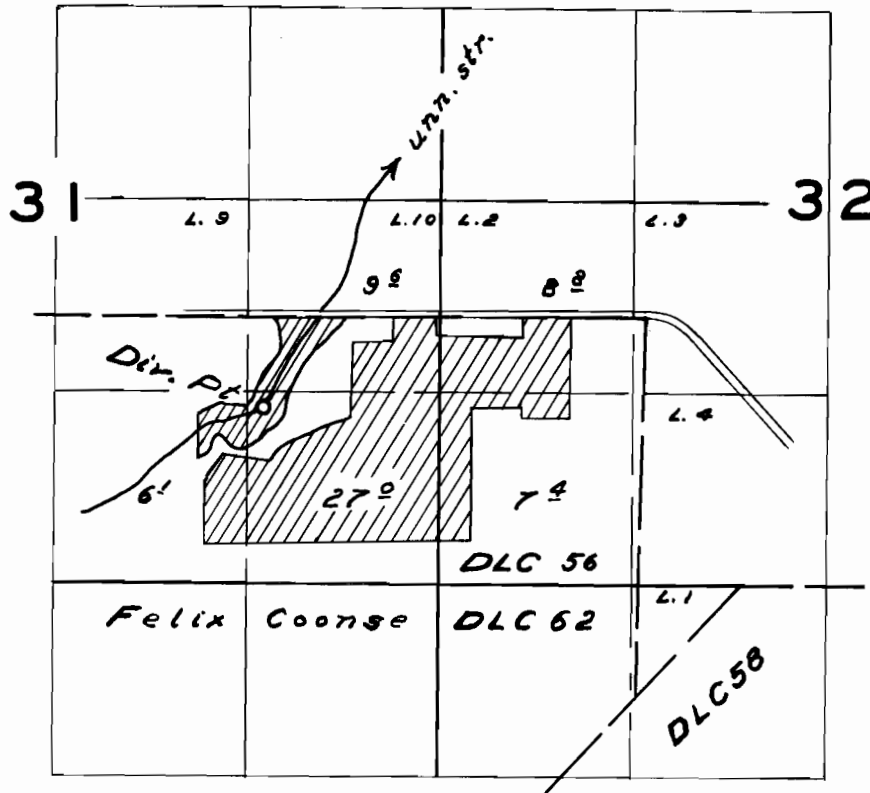

FINAL PROOF SURVEY
UNDER

Application No. 27342 Permit No. 21530
IN NAME OF

Veronica Kuschnick

Surveyed June 24 1958, by *M. Bish*