


T.6S. R.1E.W.M.

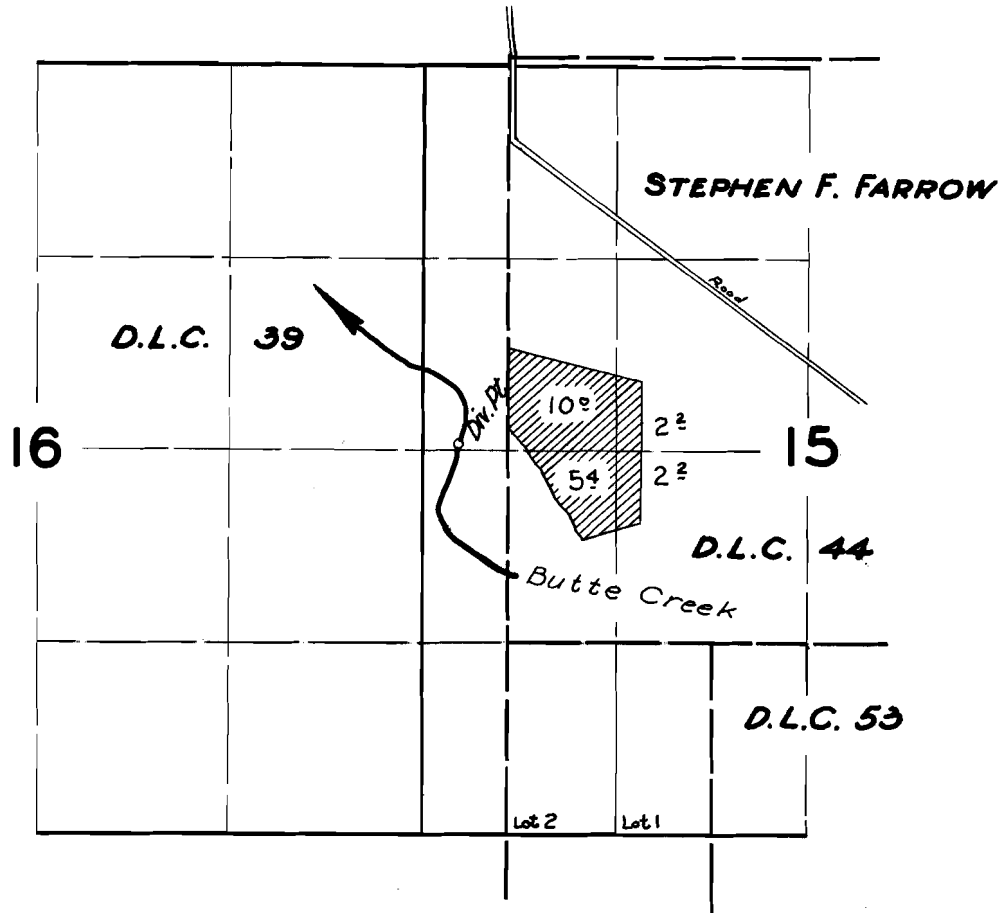

FINAL PROOF SURVEY
UNDER

Application No. 27495 Permit No. 21641
IN NAME OF

SYLVESTER TERRY

Surveyed 29 Aug. 1958, by M. Bish

MB