


T. 2S. R. 3E. W.M.

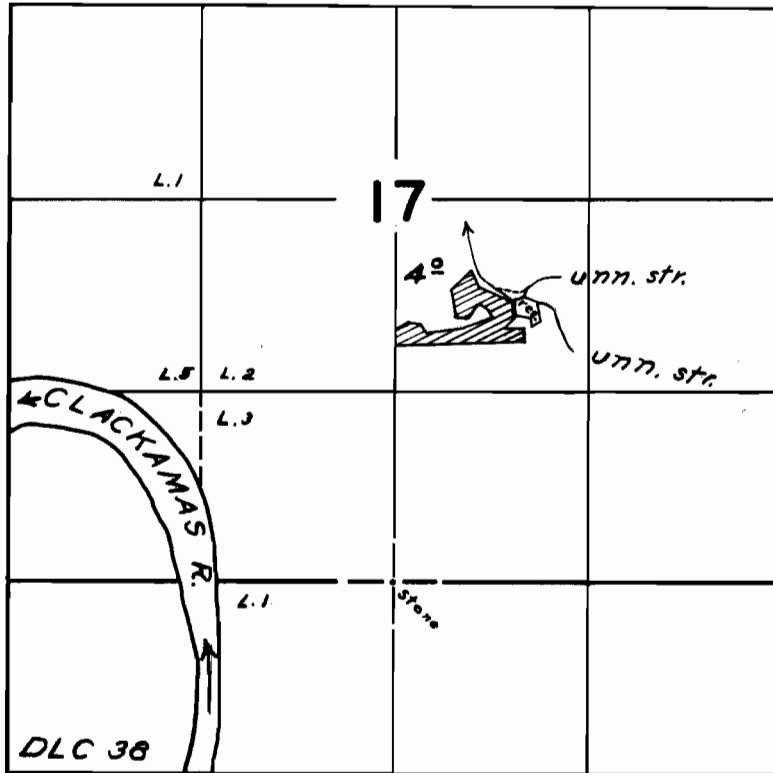

FINAL PROOF SURVEY
UNDER

R-27135 R-1409
Application No. 27136 Permit No. 21666
IN NAME OF

..... *Milton D. Helm*

Surveyed *Oct. 10 1958*, by *W. N. Perry*..