


T.5S. R.6W.W.M.

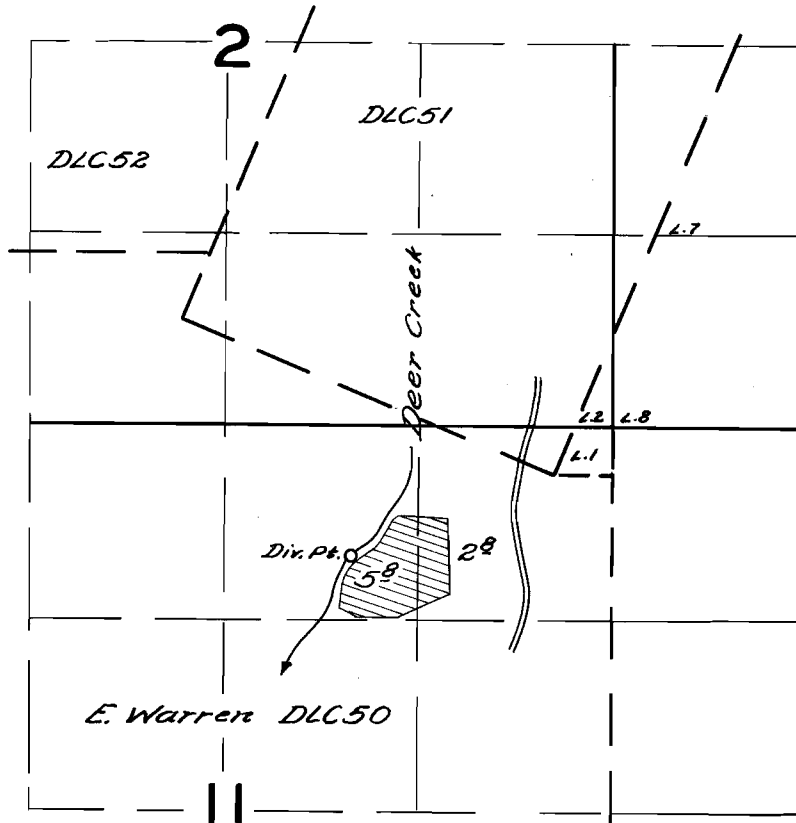

**FINAL PROOF SURVEY**  
UNDER

Application No. 27636 Permit No. 21768  
IN NAME OF

C.M. Pomeroy

Surveyed April 9, 1958, by M. Bish