


T.12S. R. 5W.W.M.

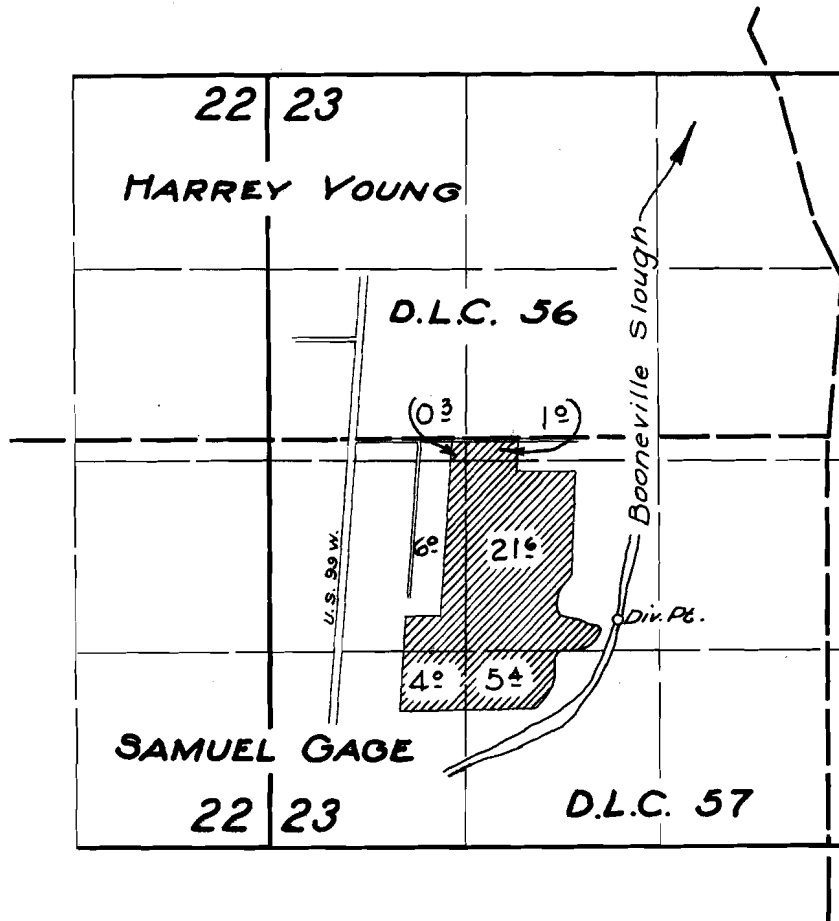

FINAL PROOF SURVEY
UNDER

Application No. 27743 Permit No. 21849
IN NAME OF

RICHARD M. & JANE R. B. HANSON

Surveyed 25 Sept. 1958, by M. Bish
Rf