


T. 4 S. R. 4 W. W. M.

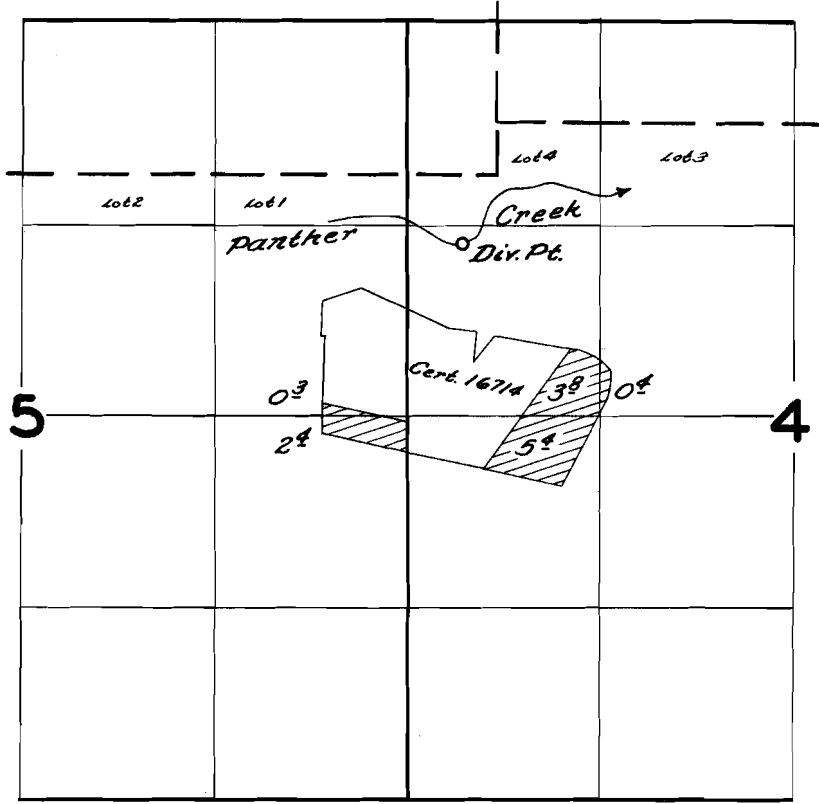

**FINAL PROOF SURVEY**  
UNDER

Application No. 27896 Permit No. 21895  
IN NAME OF

John Douglas Macy

Surveyed June 6, 1958, by M. Bish