


T. 3 S. R. 4 W. W. M.

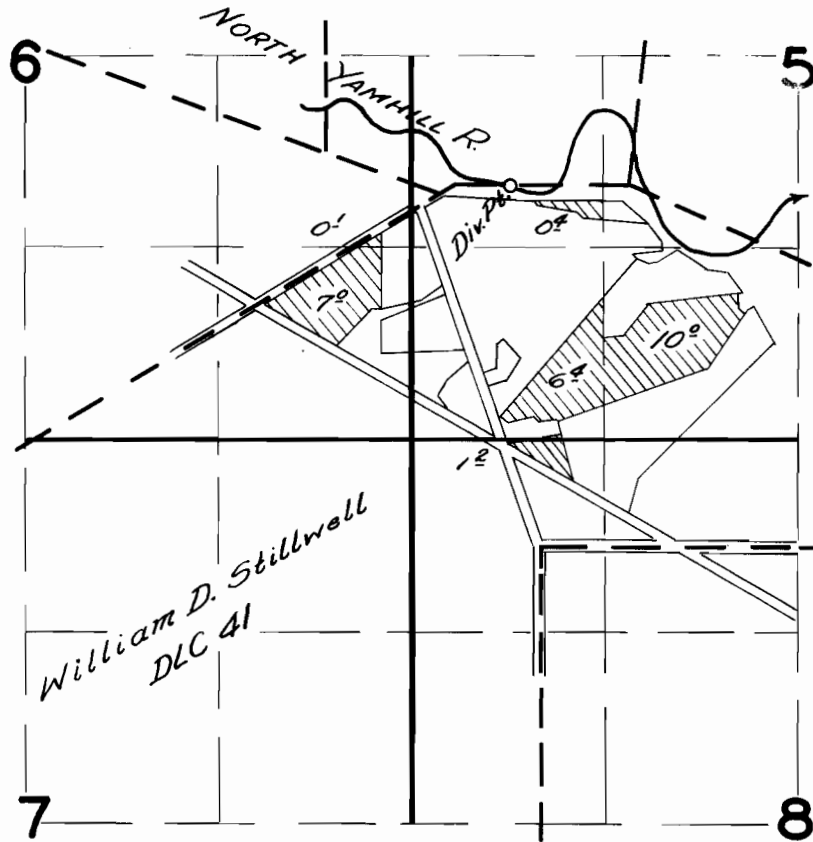

FINAL PROOF SURVEY
UNDER

Application No. *28292* Permit No. *22244*
IN NAME OF

Harry H. Williams

Surveyed *May 8, 1958*, by *M. Bisk*