


T.2S. R.1E.W.M.

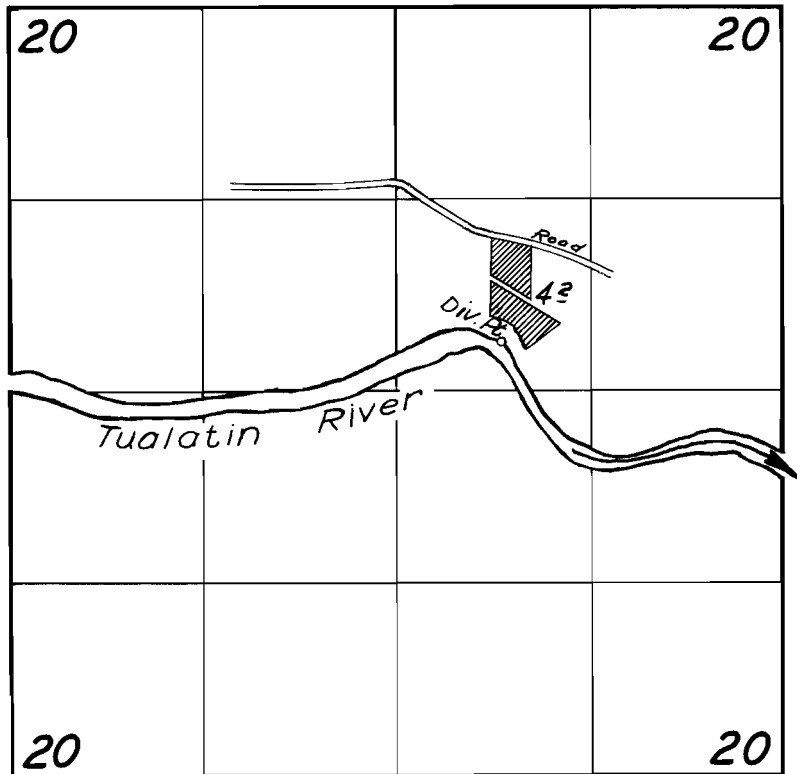

FINAL PROOF SURVEY
UNDER

Application No. 28378. Permit No. 22389
IN NAME OF

CORBETT MCLEAN

Surveyed 7 Nov. 1958, by M. Bish

RF