


T. 2 S. R. 5 W. W. M.

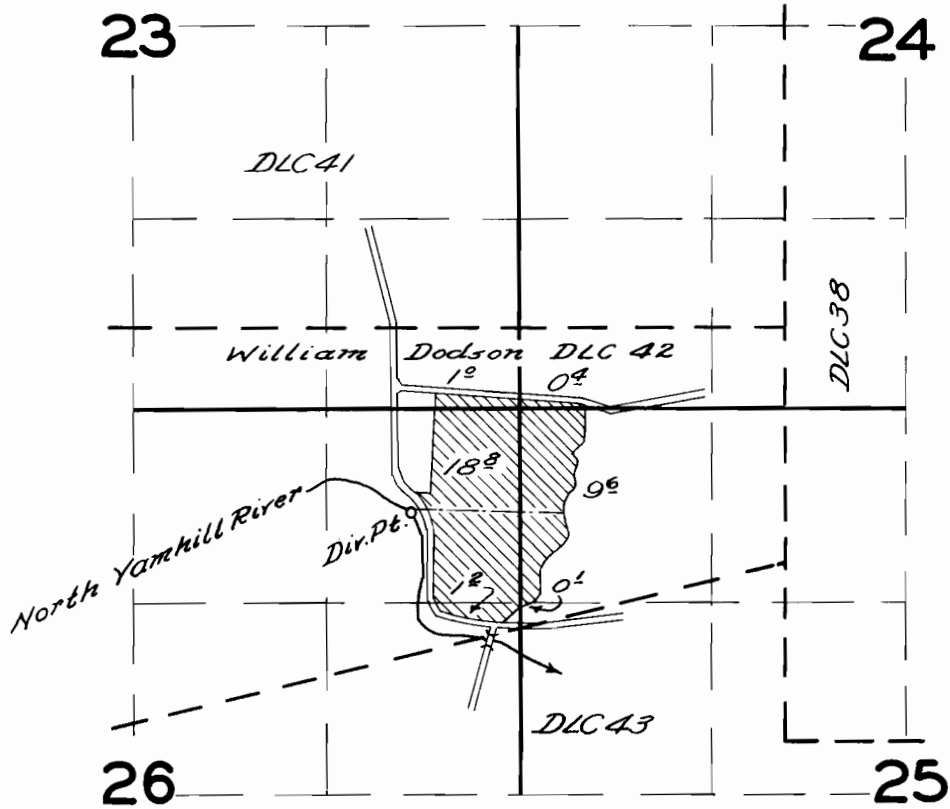

FINAL PROOF SURVEY UNDER

Application No. 28403 Permit No. 22642
IN NAME OF

Elmer E. Rist

Surveyed May 8, 1958, by *M. Bisk*