


T.3 S.R.16 E.W.M.

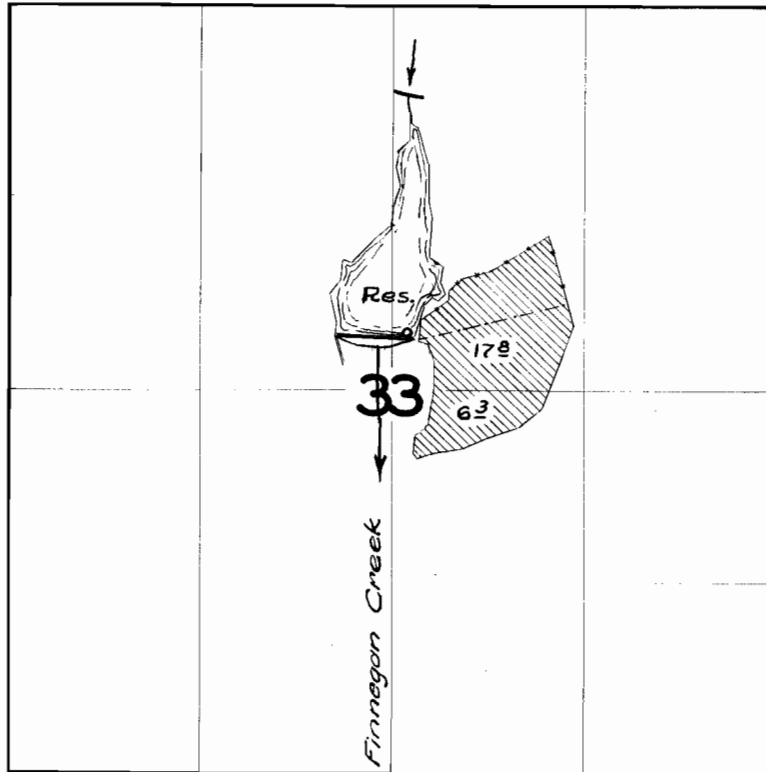

FINAL PROOF SURVEY
UNDER

Application No. ²⁸⁴⁰⁶~~R-28405~~ Permit No. ²²⁶⁴³~~R-1567~~
IN NAME OF

JOHN BUETHER

Surveyed 28 Oct. 1958, by M. Bech