


T.7S. R.1E.W.M.

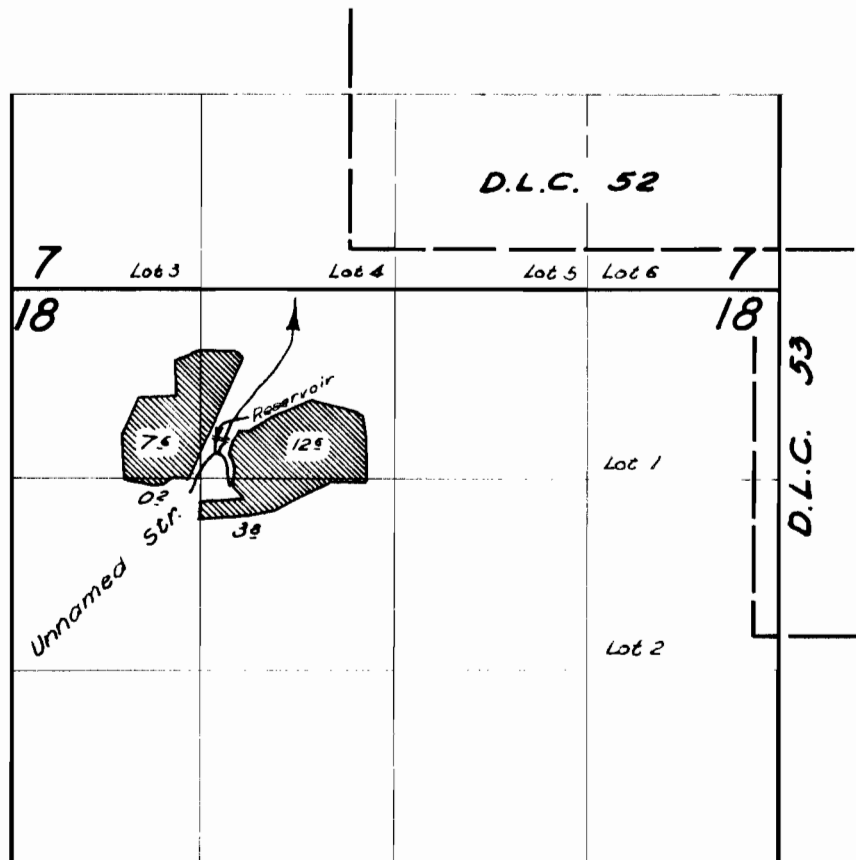

FINAL PROOF SURVEY
UNDER

Application No. 28737 Permit No. 22653
IN NAME OF

KARL HESS

Surveyed 29 July 1958, by M. Bish