


26140
82098
82503

T. 23 S. R. 6 E. W. M.

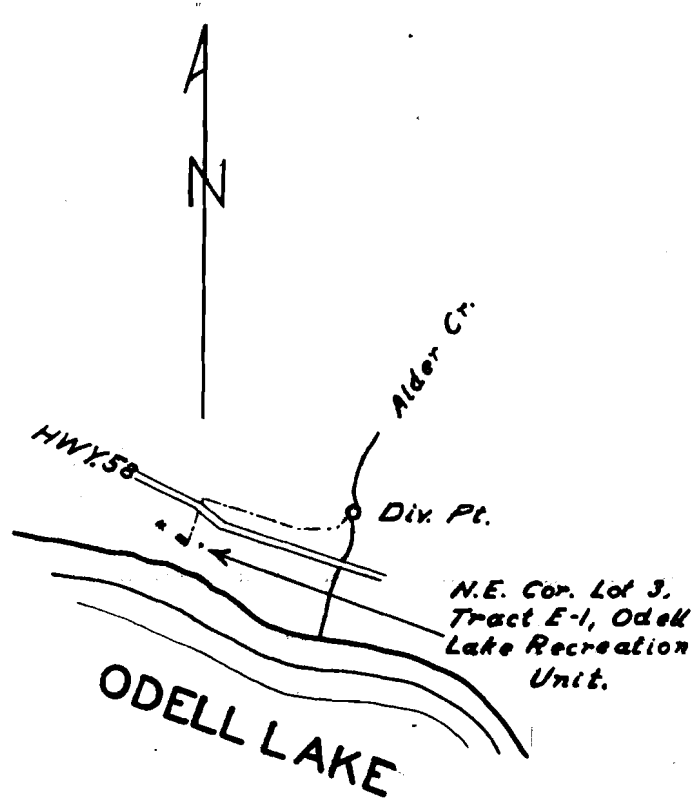

FINAL PROOF SURVEY
UNDER

Application No. 28876 Permit No. 22707
IN NAME OF

Loran L. Stewart

Surveyed Oct. 15, 1958, by W. N. Perry