


T. 5S. R. 3W. W.M.

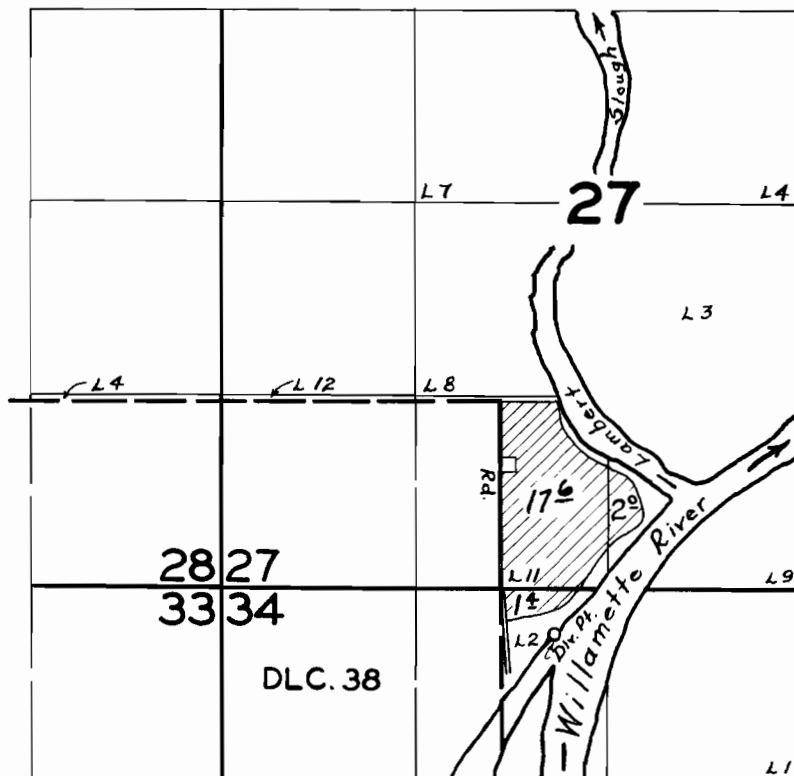

FINAL PROOF SURVEY
UNDER

Application No. **29020** Permit No. **22832**
IN NAME OF

ROBERT A. MAGEE

Surveyed **APR. 4 1958**, by *m. Bish*