


T. 5S. R. 3W. W.M.

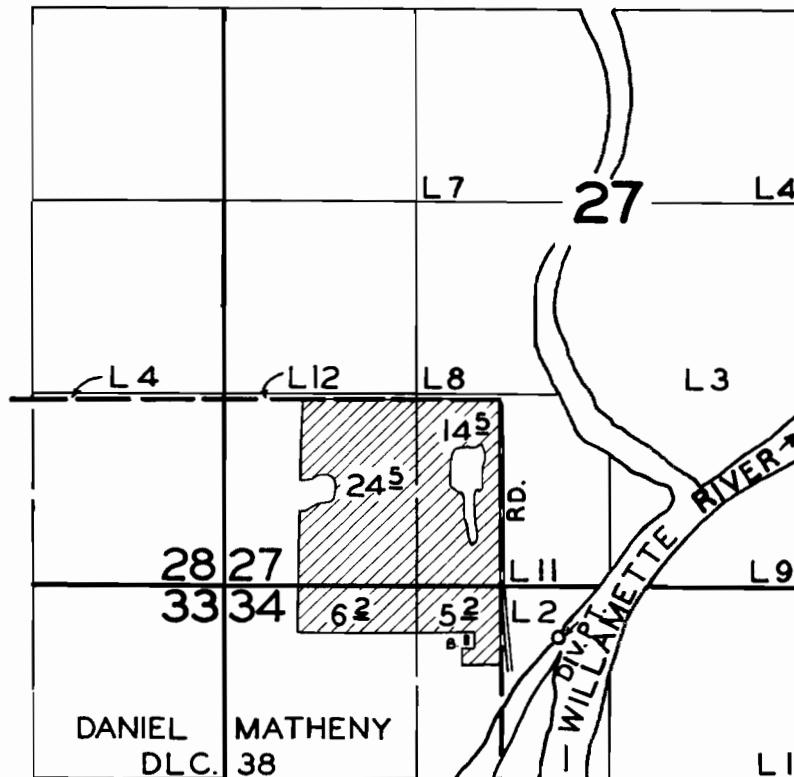

**FINAL PROOF SURVEY**  
UNDER

Application No. **29021** Permit No. **22833**  
IN NAME OF

**LOUIS W. MAGEE**

Surveyed **APR. 4 1958**, by *m. Bish*