


T. 1 N. R. 4 W. W.M.

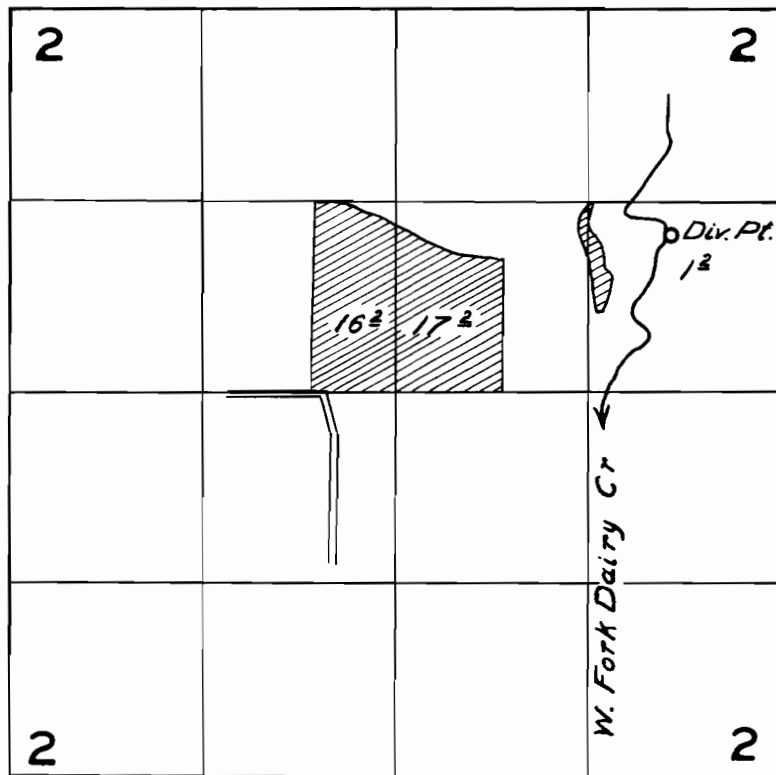

FINAL PROOF SURVEY
UNDER

Application No. *29042* Permit No. *22042*
IN NAME OF

Ray Dierickx

Surveyed *July 2, 1958*, by *M. Bish*