


T.5 S. R. 4 W. W.M.

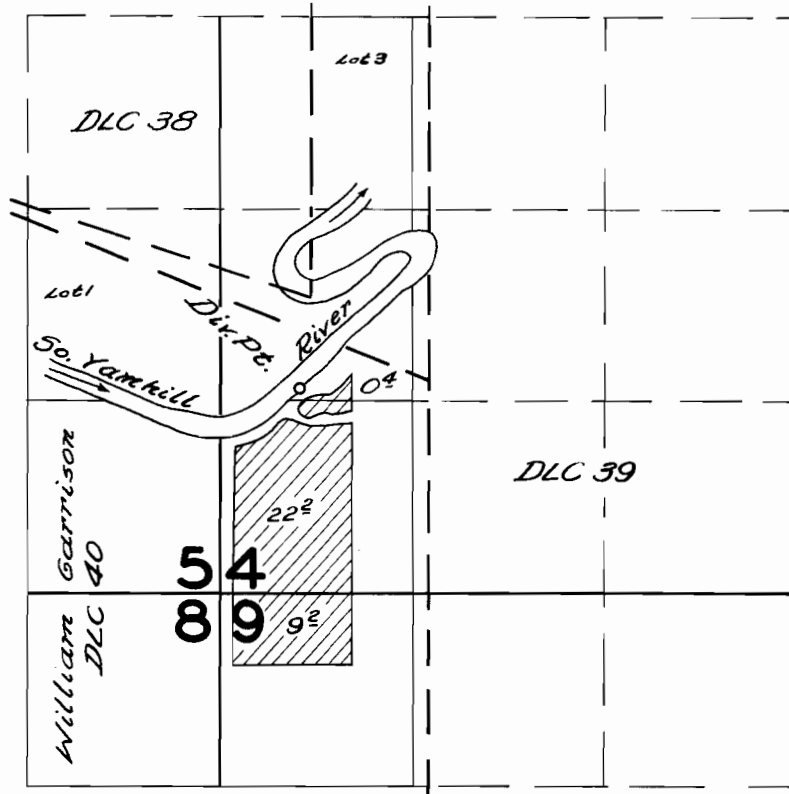

FINAL PROOF SURVEY
UNDER

Application No. 29016 Permit No. 22907
IN NAME OF

Sam Weaver

Surveyed June 3, 1958, by M. Bisk