


T. 5S. R. 3W. W.M.

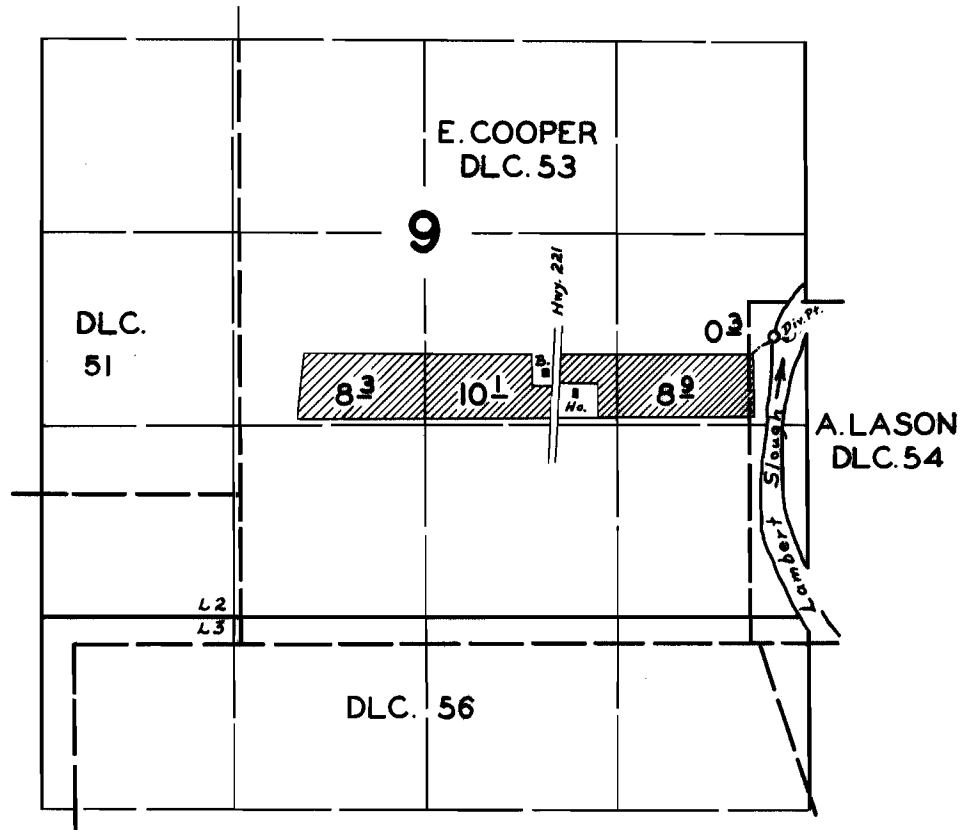

FINAL PROOF SURVEY
UNDER

Application No. 29245. Permit No. 23007
IN NAME OF

ROYAL W. HIBBS

Surveyed APR. 3, 1958, by M. BISH