


T. 2N. R. 3W.W.M.

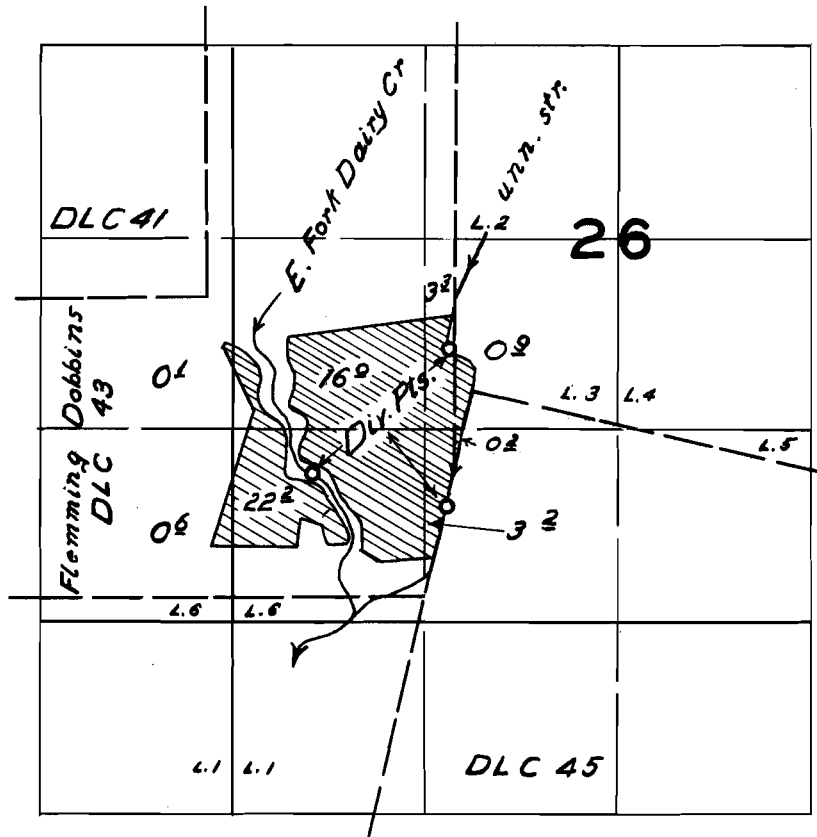

**FINAL PROOF SURVEY**  
UNDER

Application No. 27796 Permit No. 23050  
IN NAME OF

*Paul H. & Anita F. Clark*

Surveyed July 3, 1958, by *M. Bish*