


T.29S.R.15W.W.M.

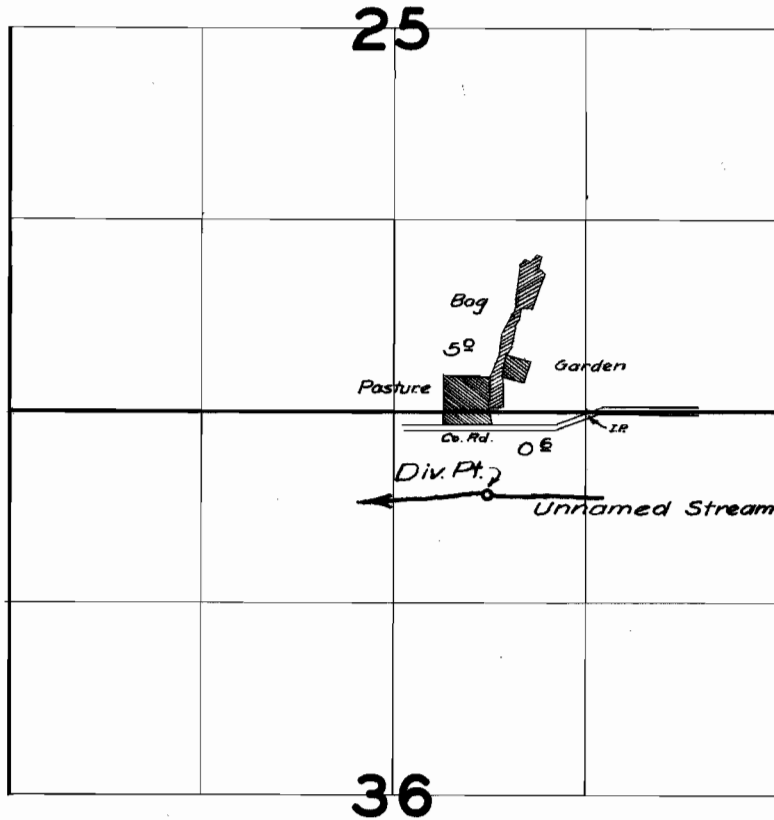

FINAL PROOF SURVEY
UNDER

Application No. 29188 Permit No. 23069
IN NAME OF

Oliver C. Waldvogel

Surveyed 24 April 1958, by M. Bish