


T. 1 & 2N. R. 3W. W.M.

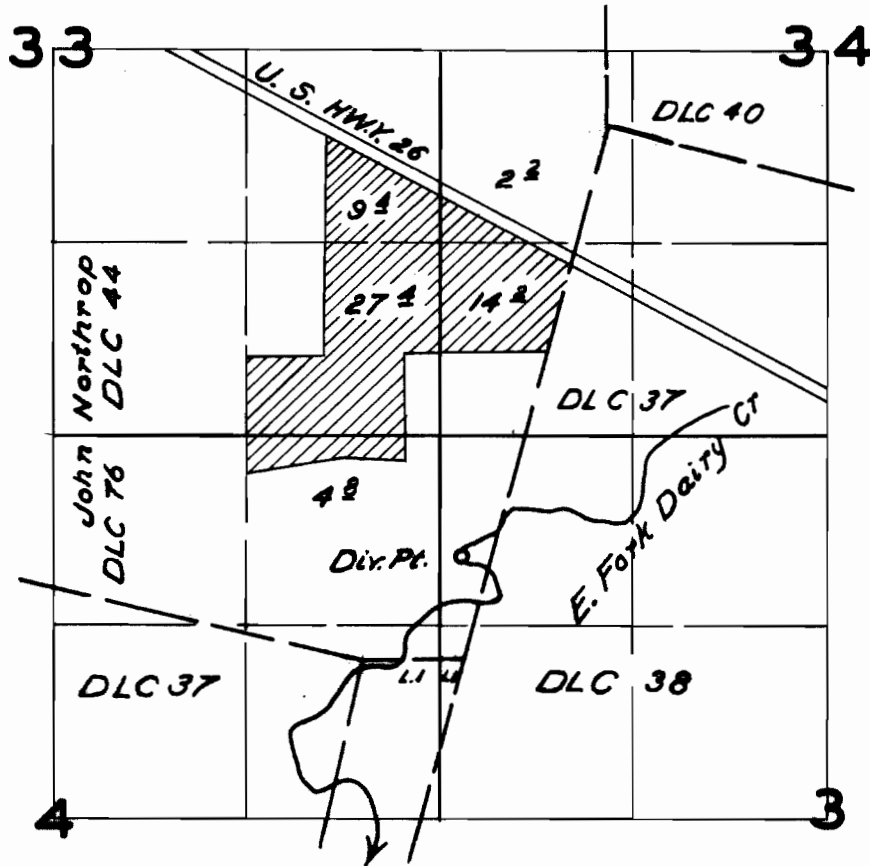

FINAL PROOF SURVEY
UNDER

Application No. 29312 Permit No. 23084.
IN NAME OF

.....*E. H. Duyck*.....

Surveyed *July 3* 1958, by *M. B. Ish*.....