T. 23S. R. 32E. W.M.

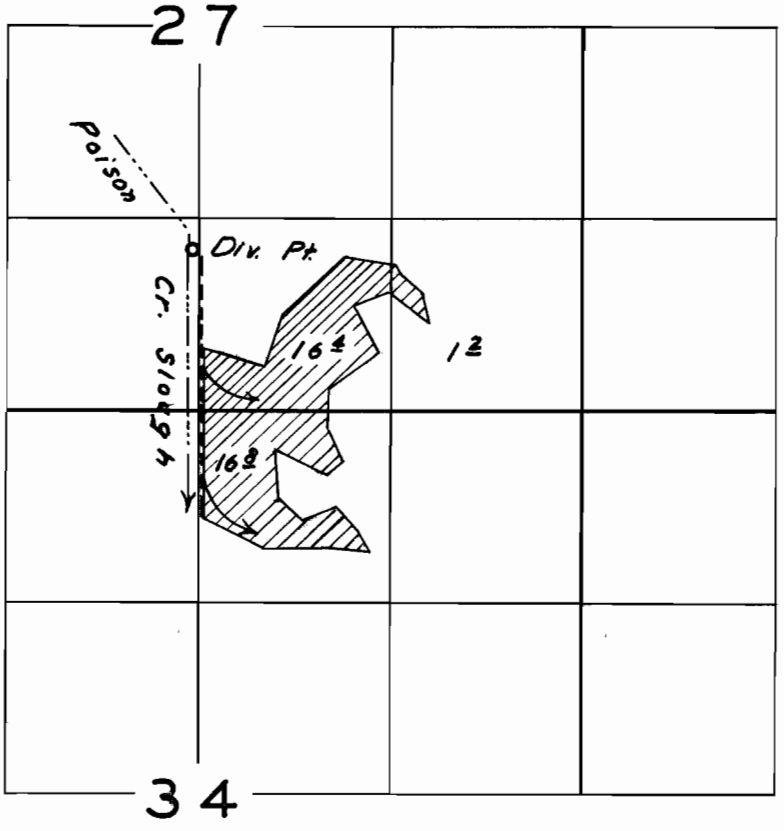

FINAL PROOF SURVEY
UNDER

Application No. 29379 Permit No. 23101
IN NAME OF

Treffle J. & Bessie Duhaime

Surveyed July 23 1958, by W.N. Perry

1958-P