


T.3S. R.2W.W.M.

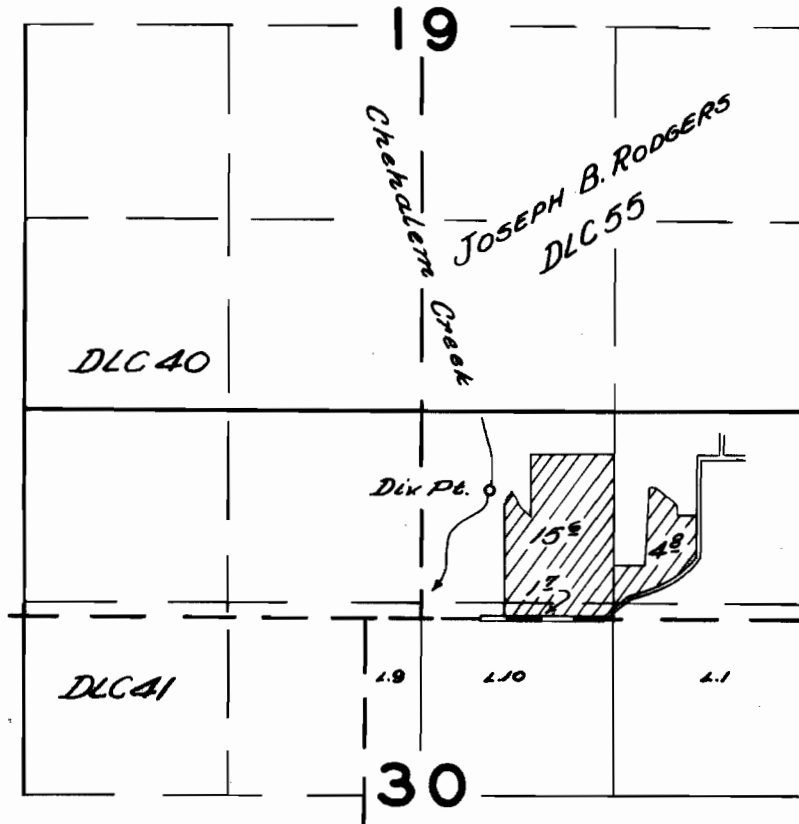

FINAL PROOF SURVEY
UNDER

Application No. 29366. Permit No. 23140
IN NAME OF

Maurice E. & Elizabeth Cronin

Surveyed *May 12, 1958*, by *M. BISH*