


T.4 S.R.17 E.W.M.

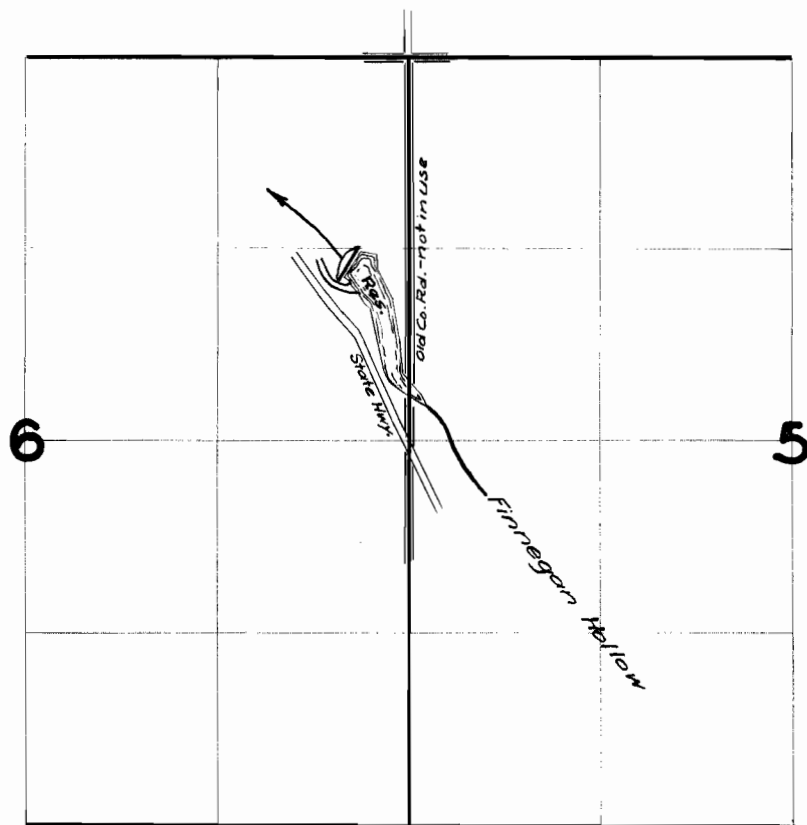

FINAL PROOF SURVEY
UNDER

Application No. 29641 R-29528 Permit No. 23252 R-1684
IN NAME OF

THEODORE VON BORSTEL

Surveyed 27 Oct. 1957, by M. B. Sch