


T. 4S. R. 1W. W.M.

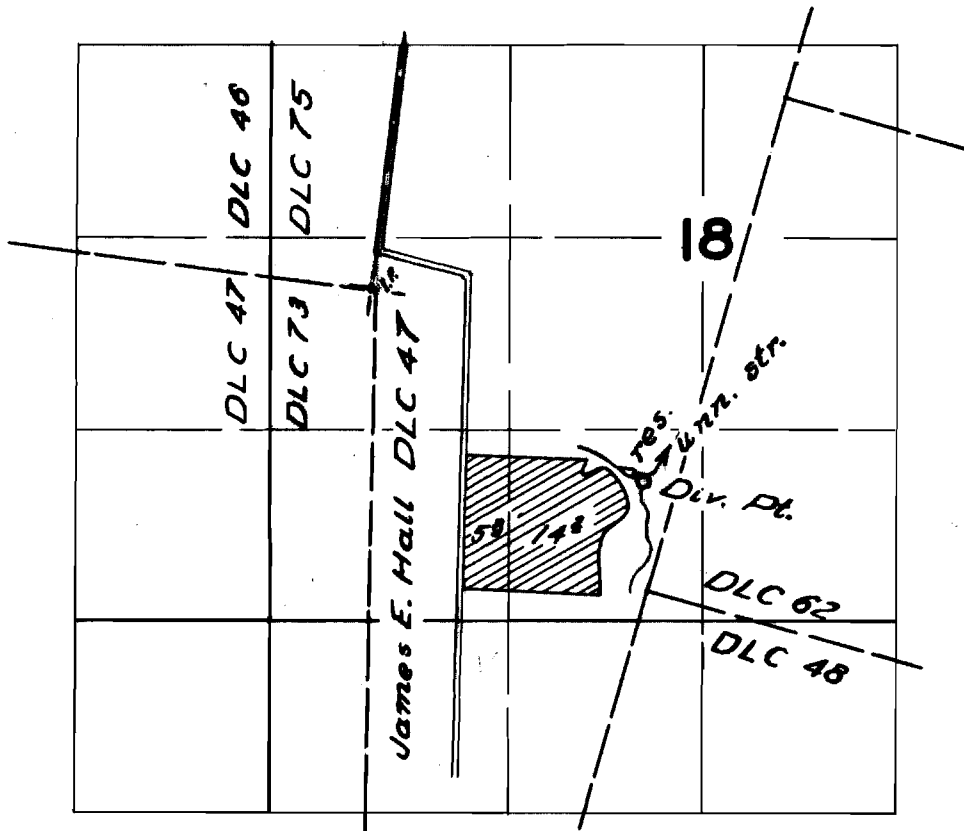

FINAL PROOF SURVEY
UNDER

R-29594 R-1697
Application No. 29595 Permit No. 23304
IN NAME OF

Lars Underland

Surveyed June 25 1958, by M. Bish