


T. 3 S. R. 4 W. W. M.

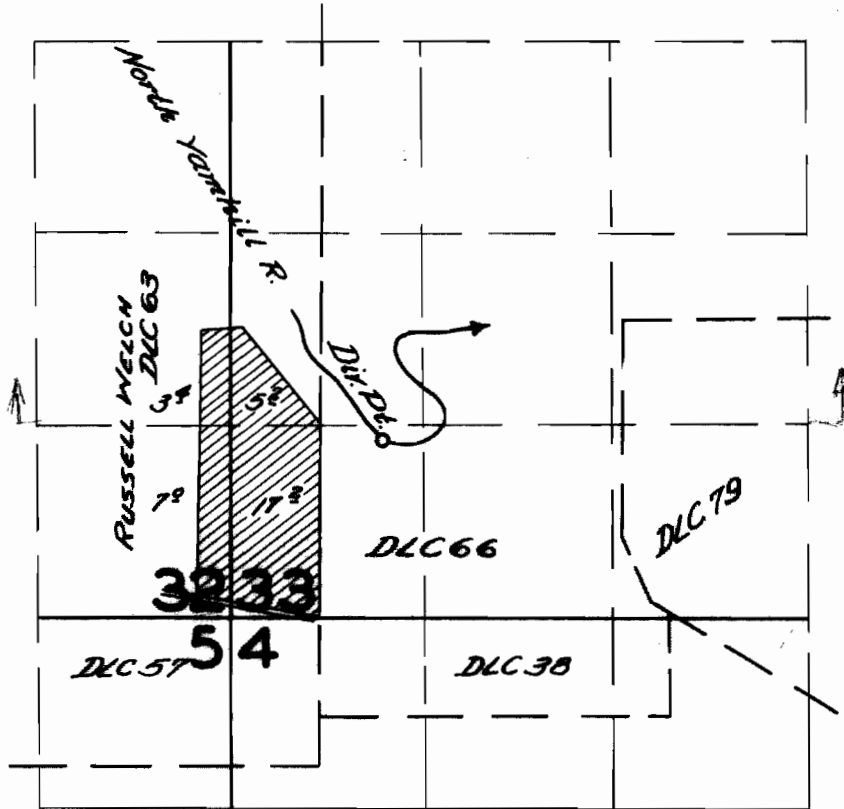

FINAL PROOF SURVEY
UNDER

Application No. 29631 Permit No. 23342
IN NAME OF

CHARLES E. SITTON

Surveyed MAY 6 1958 by M. Bish