


T.1S.R.25 E.W.M.

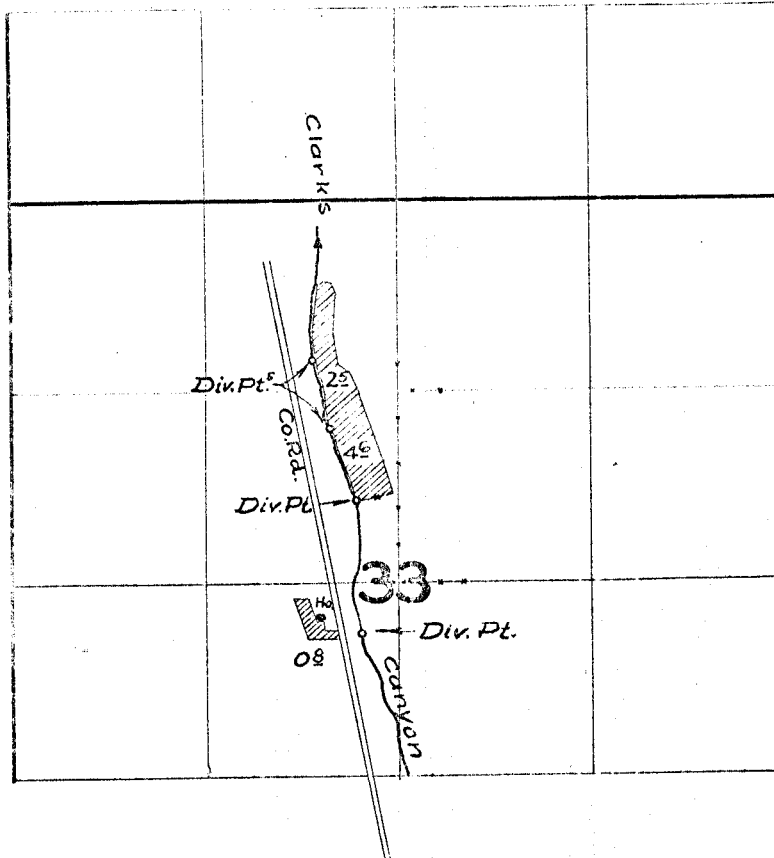

FINAL PROOF SURVEY UNDER

Application No. 29,663. Permit No. 23359.
IN NAME OF

.....VERNON E. MUNKERS.....

Surveyed 22 Oct. 1958, by *Wm. B. Rich*