


T.1 S.R.25 E.W.M.

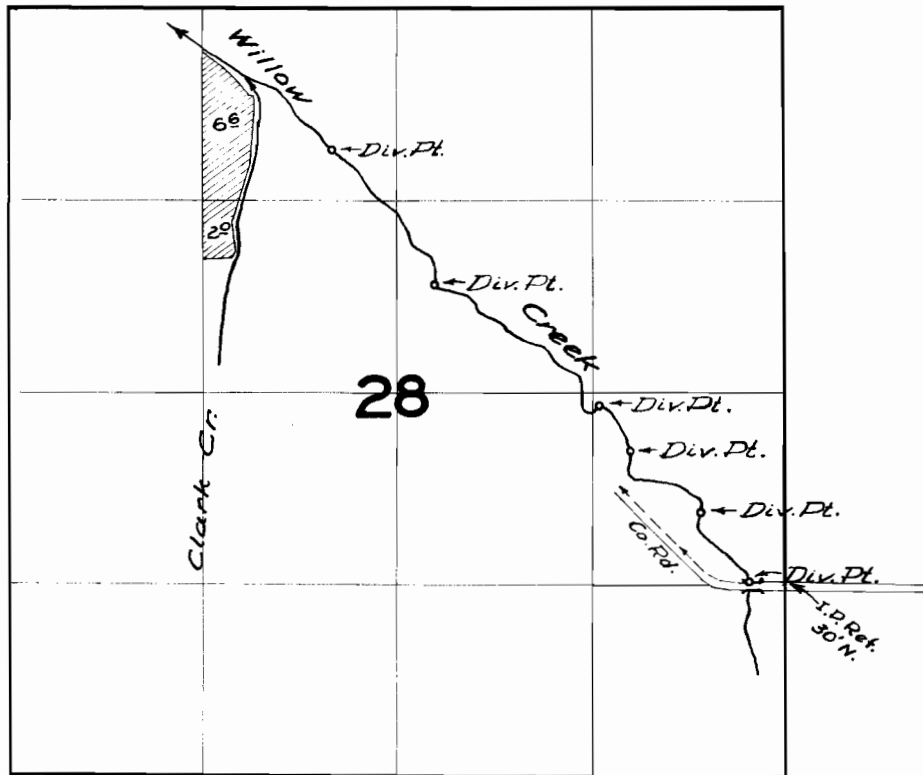

FINAL PROOF SURVEY UNDER

Transfer No. W-67

Application No. 2983.5 Permit No. 23464.
IN NAME OF

.....ALVIN E. WAGENBLAST.....

Surveyed 20 Oct. 1958, by *Tom Bish*.....