


T. 2N. R. 4W. W.M.

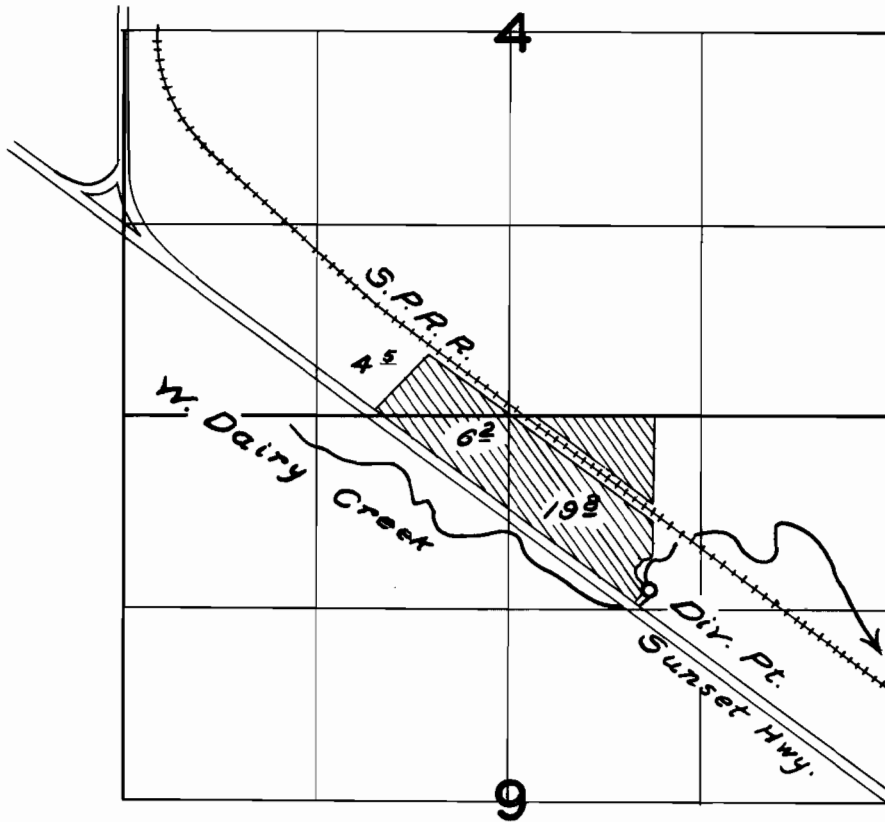

FINAL PROOF SURVEY
UNDER

Application No. *29779* Permit No. *23506*
IN NAME OF

H. E. McGraw

Surveyed *June 30* 19*58*, by *M. Bish.*