


T. 3 S. R. 3 W. W.M.

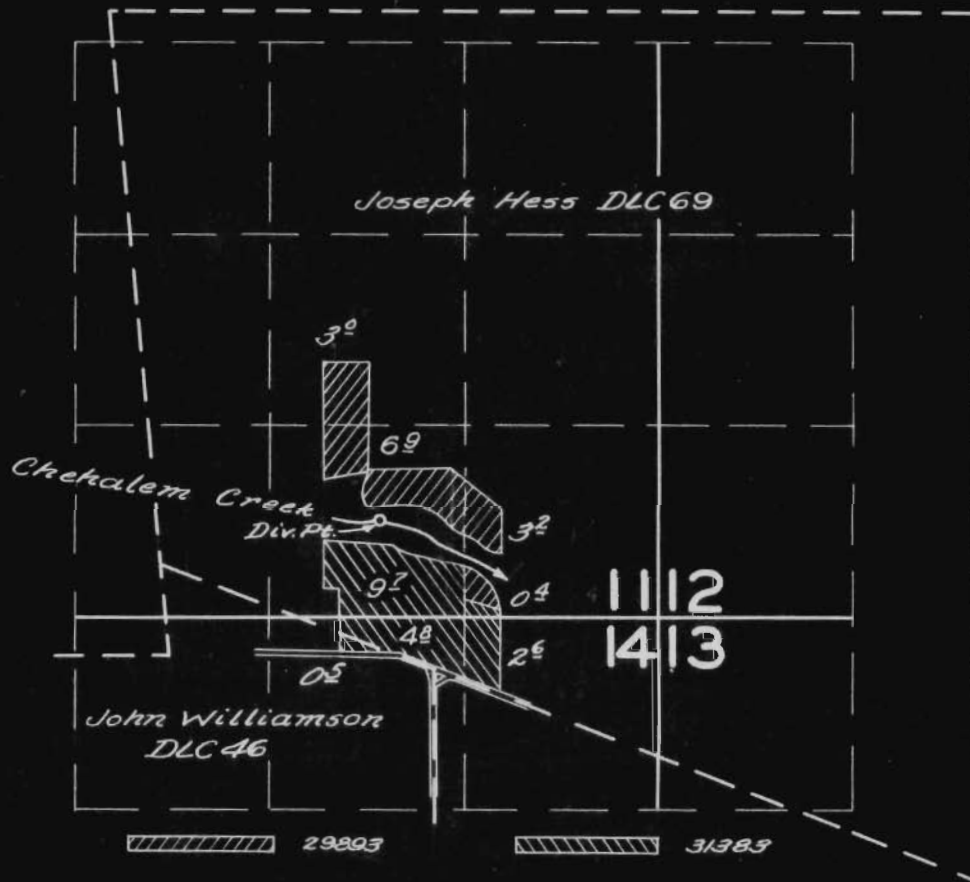

FINAL PROOF SURVEY
UNDER

Application No. *31383* Permit No. *24744*
29893 IN NAME OF

Ray A. Thomas
Ray A. & Stewart L. Thomas

Surveyed *May 12 1958*, by *M. Bish*