


# T. 1 S. R. 27 E. W. M.

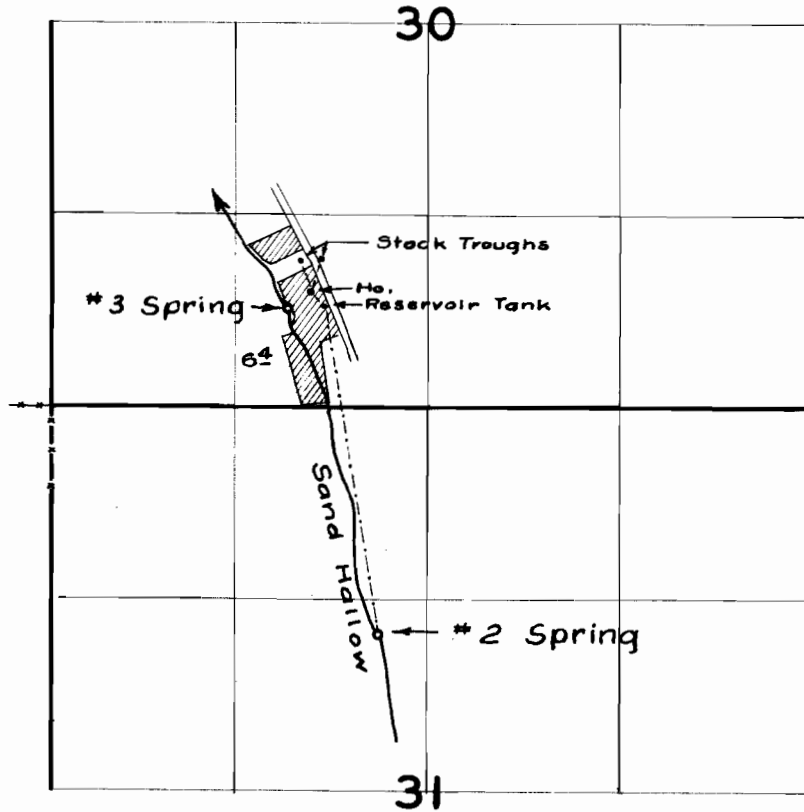

## FINAL PROOF SURVEY UNDER

Application No. 30115... Permit No. 23770  
IN NAME OF

.....RAY K. DRAKE.....

Surveyed 21 Oct. 1958, by *m. Bieh*