


T.30S.R.11 W.W.M.

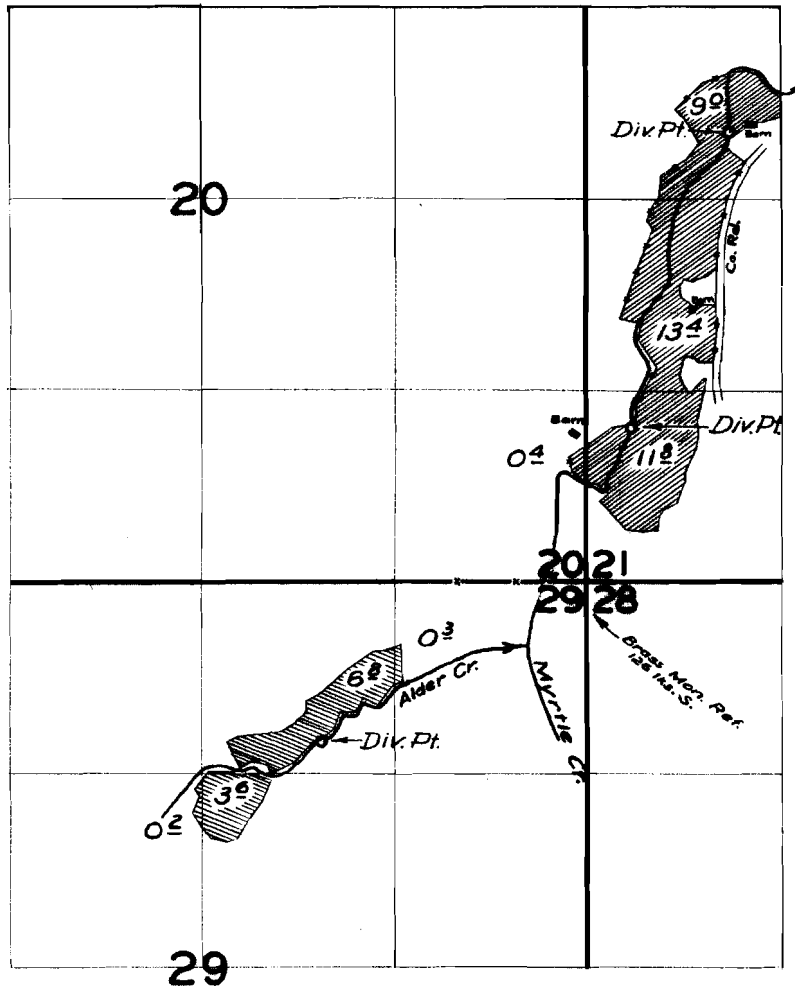

FINAL PROOF SURVEY
UNDER

Application No. 30340 Permit No. 23867
IN NAME OF

Frank J. Fish

Surveyed 19 June 1958, by *M. Bish*